

MISSISSIPPI DEPARTMENT OF NATURAL RESOURCES

Bureau of Land and Water Resources

Southport Mall

P.O. Box 10631

Jackson, Mississippi 39209

COASTAL DRILLING & SERVICE CO.

ROUTE 1 BOX 618

BILOXI MISS, firm name

county well located

Harrison
G.378

CODED

Harrison

4/12/12
date well completed

LANDOWNER: Wade Clark
North Sun Road
Sgt. Ma
(mailing address)

description of formations encountered

from to

Top Soil	1	3
Red Clay	3	18
White Sand	18	60
Soft Blue Clay	60	180
Orange white sand	180	230
Soft Blue Clay	230	310
hard Blue Clay	310	510
Rock	510	511
fine water sand	511	580
good water sand	580	580

WELL LOCATION:

sec 27 T. 6 N R. 11 E
S W
1/2 N.W. Leymon
(distance) (direction) (nearest town)

WELL PURPOSE:

(home, irrigation, municipal, industrial)

WELL COMPLETION DATA:

- (1) diameter (inches) 2"
- (2) total depth (feet) 580'
- (3) static water level (feet) 75' below top of ground
- (4) casing PVC 570'
(material) (depth)
- (size) if telescope see back.
- (5) screen 10' 570'
(length) (depth to top)
- 2" PVC
(size) (material)
- (6) pump None 12
(HP) (yield gpm)
- Ele
(type power)
- (7) electric log no
(yes or no)

CODED

(organization running log)

(8) how well bottom plugged

2" back with valve
DRILLERS REMARKS: 19-B


DEPT. OF NATURAL RESOURCES
BUREAU OF LAND & WATER RESOURCES

OCT 14 1982

RECEIVED

If well telescopes please sketch and show depths.

GROUND LEVEL

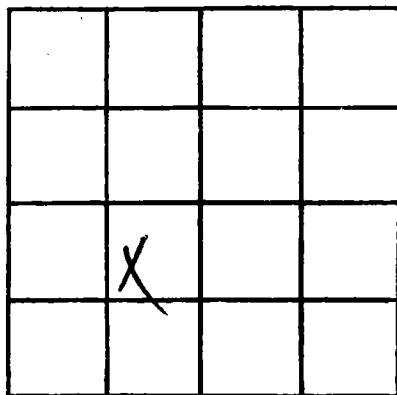

SECTION _____

Please indicate well location X.

ADDITIONAL INFORMATION

If more than one screen, show locations of each on sketch.