

MISSISSIPPI DEPARTMENT OF NATURAL RESOURCES

Bureau of Land and Water Resources

Southport Mall

P.O. Box 10631

Jackson, Mississippi 39209

**CODED**

COASTAL DRILLING & SERVICE CO. WATER WELL DRILLERS LOG

ROUTE 1 BOX 618

BILOXI, MISS. 39532

*Hannover*  
county well located

*Hannover*  
*G37A*

*3/14/82*  
date well completed

LANDOWNER: *Fred Fayard*  
*Quincy Hill Farm*  
*apt 401*  
(mailing address)

description of formations encountered	from	to
<i>top soil</i>	<i>1</i>	<i>3</i>
<i>Red Clay</i>	<i>3</i>	<i>15</i>
<i>white sand</i>	<i>15</i>	<i>65</i>
<i>Soft Blue Clay</i>	<i>65</i>	<i>190</i>
<i>White Water Sand</i>	<i>190</i>	<i>225</i>
<i>Red Blue Clay</i>	<i>225</i>	<i>310</i>
<i>Hard Blue Clay</i>	<i>310</i>	<i>470</i>
<i>fine water sand</i>	<i>470</i>	<i>540</i>
<i>good water sand</i>	<i>540</i>	<i>570</i>

WELL LOCATION:  
sec *31* T *6* S R. *11* W  
*2 1/2* mil North *New Hope*  
(distance) (direction) (nearest town)

WELL PURPOSE: *lime*  
(home, irrigation, municipal, industrial)

WELL COMPLETION DATA:

(1) diameter (inches) *2"*

(2) total depth (feet) *570'*

(3) static water level (feet) *90'* below top of ground.

(4) casing *pcx*, *560'*  
(material) (depth)

(size) if telescope see back.

(5) screen *10'*, *560'*  
(length) (depth to top)

*2"*  
(size) *pcx*  
(material)

(6) pump *1 1/2* *10*  
(HP) (yield gpm)

*ele*  
(type power)

(7) electric log *no*  
(yes or no)

(organization running log)

**CODED**

(8) how well bottom plugged  
*2 inch well value*  
DRILLERS REMARKS: *196*


DEPT. OF NATURAL RESOURCES  
BUREAU OF LAND & WATER RESOURCES

OCT 14 1982

**RECEIVED**

If well telescopes please sketch and show depths.

GROUND LEVEL

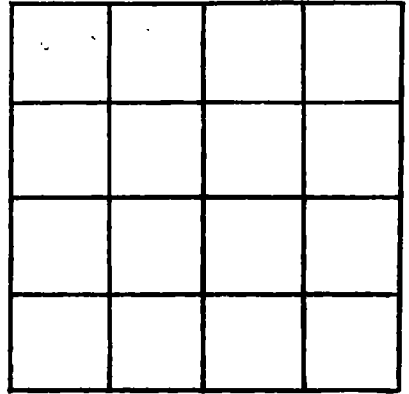

SECTION \_\_\_\_\_

Please indicate well location X.

**ADDITIONAL INFORMATION**

If more than one screen, show locations of each on sketch.