

MISSISSIPPI DEPARTMENT OF NATURAL RESOURCES
Bureau of Land and Water Resources
 Southport Mall
 P.O. Box 10631
 Jackson, Mississippi 39209
WATER WELL DRILLERS LOG

CODED

Harrison
G385

8/5/82 19 Lyman Well Co. Harrison
 date well completed firm name county well located

LANDOWNER: D & L Farm
401 St. Charles St.
Gulfport, Md 39503
 (mailing address)

description of formations encountered	from	to
<u>Top soil</u>	<u>0</u>	<u>5</u>
<u>Red clay</u>	<u>5</u>	<u>210</u>
<u>Blue clay</u>	<u>40</u>	<u>204</u>
<u>sand fin</u>	<u>201</u>	<u>235</u>

WELL LOCATION:
 sec 21 T 6 N R 11 E
9 miles SW of Got
 (distance) (direction) (nearest town)

CODED

WELL PURPOSE:
 (home, irrigation, municipal, industrial)

WELL COMPLETION DATA:

(1) diameter (inches) 4"

(2) total depth (feet) 235

(3) static water level (feet) 42 below above top of ground.

(4) casing pac 235
 (material) (depth)
4"
 (size) if telescope see back.

(5) screen 10" 225
 (length) (depth to top)
6" pac
 (size) (material)

(6) pump 1 25
 (HP) (yield gpm)
A
 (type power)

(7) electric log X
 (yes or no)

(8) how well bottom plugged _____
 (organization running log)

DEPT. OF NATURAL RESOURCES
 BUREAU OF LAND & WATER RESOURCES


FEB 28 1983

DRILLERS REMARKS:
Reaming screen
pack

RECEIVED

If well telescopes please sketch and show depths.

GROUND LEVEL

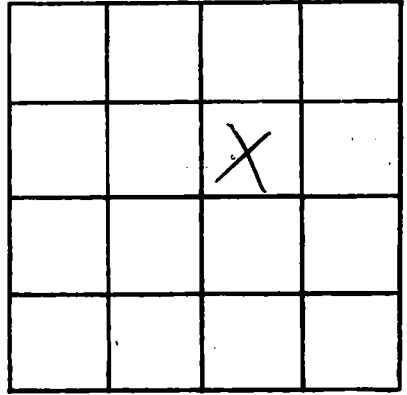

SECTION 21

Please indicate well location X.

ADDITIONAL INFORMATION

If more than one screen, show locations of each on sketch.