

Harrison
G386

MISSISSIPPI DEPARTMENT OF NATURAL RESOURCES
Bureau of Land and Water Resources
Southport Mall
P.O. Box 10631
Jackson, Mississippi 39209
WATER WELL DRILLERS LOG

CODED

8-8-82 19 Lynam Well Co. Harrison
date well completed firm name county well located

LANDOWNER: Gilbert
Weaver Hwy 53
Gulfport, MS 39503
(mailing address)

description of formations encountered	from	to
clay	0	50
Red sand	50	100
Clay	100	140
Grdy Sand	140	190

WELL LOCATION:
sec. 19 T. 6 N. R. 11 E.
12 miles N of Gpt
(distance) (direction) (nearest town)

CODED

WELL PURPOSE:
(home, irrigation, municipal, industrial)

WELL COMPLETION DATA:

- (1) diameter (inches) 2"
- (2) total depth (feet) 190'
- (3) static water level (feet) 35 below above top of ground.
- (4) casing PVC 190'
(material) (depth)
2"
(size) If telescope see back.
- (5) screen 10' 190
(length) (depth to top)
2" PVC
(size) (material)
- (6) pump 1 12
(HP) (yield gpm)
Elect
(type power)
- (7) electric log N/O
(yes or no)
N/O
(organization running log)
- (8) how well bottom plugged Sand
Shark

DEPT. OF NATURAL RESOURCES
BUREAU OF LAND & WATER RESOURCES


FEB 25 1983

DRILLERS REMARKS:

RECEIVED

If well telescopes please sketch and show depths.

GROUND LEVEL

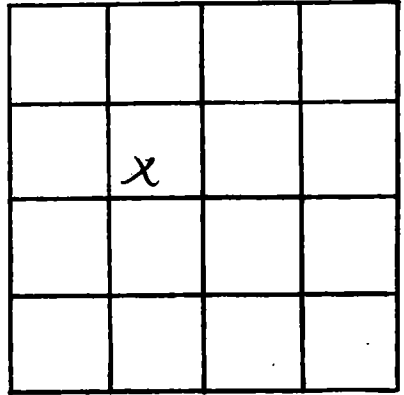

SECTION 19

Please Indicate well location X.

ADDITIONAL INFORMATION

If more than one screen, show locations of each on sketch.