

MISSISSIPPI DEPARTMENT OF NATURAL RESOURCES
 Bureau of Land and Water Resources
 Southport Mall
 P.O. Box 10631
 Jackson, Mississippi 39209
WATER WELL DRILLERS LOG

CODED

Harrison
G387

10/29/82 date well completed Apex Well Co. firm name Harrison county well located

LANDOWNER: W. H. Towles
Rt. 3, Box 539
Spt, Ms 39503
 (mailing address)

WELL LOCATION:
 sec. A-T-6-N R-11-E
0 miles (distance) of 0 (direction) of Dyman (nearest town)

WELL PURPOSE: None
 (home, irrigation, municipal, industrial)

- WELL COMPLETION DATA:
- (1) diameter (inches) 2"
 - (2) total depth (feet) 360
 - (3) static water level (feet) 30' ^{below} above top of ground.
 - (4) casing 2" or 350 (material), (depth)
 - 2" (size) if telescope see back.
 - (5) screen 10' (length), 360 (depth to top)
 - 2" (size), PVC (material)
 - (6) pump 1 (HP), 15 (yield gpm)
 - Elec. (type power)
 - (7) electric log no (yes or no)
 - no (organization running log)
 - (8) how well bottom plugged Jan

description of formations encountered	from	to
<u>Red Clay Sand</u>	<u>0</u>	<u>100</u>
<u>Blue Clay</u>	<u>100</u>	<u>230</u>
<u>Flint Sand & Clay</u>	<u>230</u>	<u>270</u>
<u>Blue Clay</u>	<u>270</u>	<u>310</u>
<u>Gravel Sand</u>	<u>310</u>	<u>360</u>

CODED

DEPT. OF NATURAL RESOURCES
 BUREAU OF LAND & WATER RESOURCES


FEB 25 1983

RECEIVED

DRILLERS REMARKS:

If well telescopes please sketch and show depths.

GROUND LEVEL

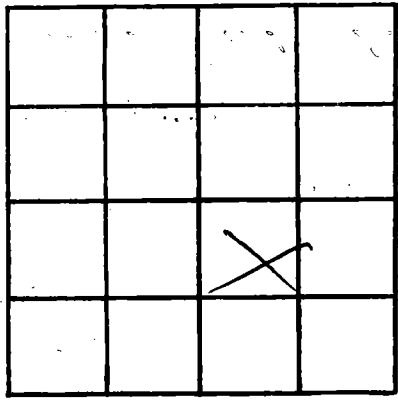

SECTION 19

Please indicate well location X.

ADDITIONAL INFORMATION

If more than one screen, show locations of each on sketch.