

MISSISSIPPI DEPARTMENT OF NATURAL RESOURCES  
 Bureau of Land and Water Resources  
 Southport Mall  
 P.O. Box 10631  
 Jackson, Mississippi 39209  
**WATER WELL DRILLERS LOG**

**CODED**

Harrison  
G388

11-27-82 19 Lyman Well Co. Harrison  
 date well completed firm name county well located

LANDOWNER: Wayne Frazier  
Rt. 3, Box 542  
Gulfport 39503  
 (mailing address)

description of formations encountered	from	to
Red sand + Gravel	0	100
Gumbo	100	260
yellow w sand	260	283
Blue clay	283	380
Good sand	380	430

WELL LOCATION:  
 sec. 19 T 6 N R. 11 E  
10 miles N of Gpt.  
 (distance) (direction) (nearest town)

WELL PURPOSE: Home  
 (home, irrigation, municipal, industrial)

- WELL COMPLETION DATA:
- diameter (inches) 2"
  - total depth (feet) 430'
  - static water level (feet) 60' <sup>below</sup> top of ground
  - casing PVC 430'  
 (material) (depth)  
2" If telescope see back.  
 (size)
  - screen 10' 430'  
 (length) (depth to top)  
2" PVC  
 (size) (material)
  - pump N/A N/A  
 (HP) (yield gpm)  
Elect  
 (type power)
  - electric log N/O  
 (yes or no)  
N/O  
 (organization running log)

(8) how well bottom plugged Sand  
Shark

DRILLERS REMARKS:

**CODED**


DEPT. OF NATURAL RESOURCES  
 BUREAU OF LAND & WATER RESOURCES

FEB 28 1983

**RECEIVED**

If well telescopes please sketch and show depths.

GROUND LEVEL

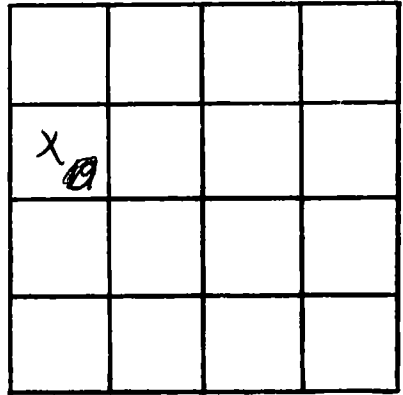

SECTION 19

Please indicate well location X.

ADDITIONAL INFORMATION

If more than one screen, show locations of each on sketch.