

MISSISSIPPI DEPARTMENT OF NATURAL RESOURCES

Bureau of Land and Water Resources

Southport Mall

P.O. Box 10631

Jackson, Mississippi 39209

WATER WELL DRILLERS LOG

CODED

Harrison
G389

12-14-82 19 Lemon Well Co. Harrison
date well completed firm name county well located

LANDOWNER: Walter Ruff
Robinson Ref
Rt. 11, Box 358 Apt
(mailing address) 39503

description of formations encountered	from	to
<u>Top soil</u>	<u>0</u>	<u>5</u>
<u>yellow clay</u>	<u>5</u>	<u>15</u>
<u>blue clay</u>	<u>15</u>	<u>90</u>
<u>sand</u>	<u>90</u>	<u>120</u>
<u>blue clay</u>	<u>120</u>	<u>180</u>
<u>yellow sand grain</u>	<u>180</u>	<u>234</u>

WELL LOCATION:
sec. 6 T. 11 N. R. 11 E.
6 miles (distance) W (direction) of Southport (nearest town)

WELL PURPOSE:
(home, irrigation, municipal, industrial)

- WELL COMPLETION DATA:
- (1) diameter (inches) 2'
 - (2) total depth (feet) 234
 - (3) static water level (feet) 21 below top of ground.
 - (4) casing PVC, 234 (material), (depth)
 - (size) 10 if telescope see back.
 - (5) screen 10, 224 (length), (depth to top)
 - 2" (size), PVC (material)
 - (6) pump 1, 15 (HP), (yield gpm)
 - elec (type power)
 - (7) electric log no (yes or no)

(organization running log)
(8) how well bottom plugged sand

DRILLERS REMARKS:

CODED


DEPT. OF NATURAL RESOURCES
BUREAU OF LAND & WATER RESOURCES

FEB 25 1983

RECEIVED

If well telescopes please sketch and show depths.

GROUND LEVEL

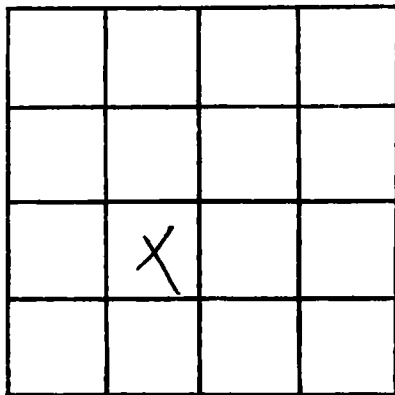

SECTION 6

Please indicate well location X.

ADDITIONAL INFORMATION

If more than one screen, show locations of each on sketch.