

MISSISSIPPI DEPARTMENT OF NATURAL RESOURCES ✓

Bureau of Land and Water Resources

Southport Mall

P.O. Box 10631

Jackson, Mississippi 39209

WATER WELL DRILLERS LOG

CODED

Harrison
G 391

2-22 1983
date well completed

McKee Well Works Inc Harrison
firm name county well located

LANDOWNER: Harland & Cindy Myechele
Rt. 1, Box 1002

description of formations encountered

from to

Holt, Ms. 39503
Thomas Road
(mailing address)

SAND	0	20
SAND	20	40
Mud	40	370
SAND	370	390
SAND	390	400
SAND	400	420

WELL LOCATION:
sec. 10 T. 6 N. R. 11 E.
6 miles SN of Crest
(distance) (direction) (nearest town)

WELL PURPOSE: home
(home, irrigation, municipal, industrial)

CODED

WELL COMPLETION DATA:

- (1) diameter (inches) 2"
- (2) total depth (feet) 420'
- (3) static water level (feet) 10' below above top of ground.
- (4) casing Sch. 40 PVC 410'
(material) (depth)
2"
(size) if telescope see back.
- (5) screen 10' 410'
(length) (depth to top)
2" Sch 80 PVC
(size) (material)
- (6) pump 1 9
(HP) (yield gpm)
electric
(type power)
- (7) electric log ---
(yes or no)

(organization running log)

(8) how well bottom plugged hard
seal


DRILLERS REMARKS:

DEPT. OF NATURAL RESOURCES
BUREAU OF LAND & WATER RESOURCES

AUG 10 1983
RECEIVED

If well telescopes please sketch and show depths.

GROUND LEVEL

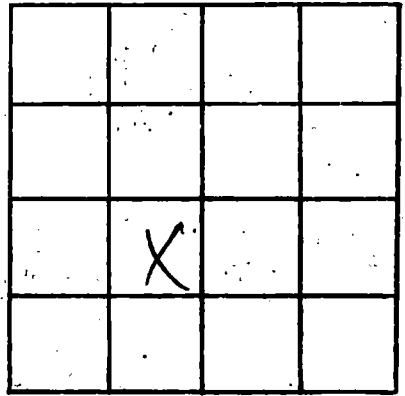

SECTION _____

Please Indicate well location X.

ADDITIONAL INFORMATION

If more than one screen, show locations of each on sketch.