

MISSISSIPPI DEPARTMENT OF NATURAL RESOURCES

Bureau of Land and Water Resources

Southport Mall

P.O. Box 10631

Jackson, Mississippi 39209

WATER WELL DRILLERS LOG

CODED

Harrison
6393

July 27 1983
date well completed

Nuneau Well Drilling
firm name

Harrison
county well located

LANDOWNER: Jarris Starley
Rt. 1 Box 620
Saucier, Ms. 39574
(mailing address)

description of formations encountered

from

to

<u>Top Sand</u>	<u>0</u>	<u>20</u>
<u>Sandy Red & Blue Clay</u>	<u>20</u>	<u>110</u>
<u>Course Sand</u>	<u>110</u>	<u>126</u>

CODED

WELL LOCATION:

sec. 7 T. 6 N. R. 11 E.
5 W
3 miles NW of Abman
(distance) (direction) (nearest town)

WELL PURPOSE: Home
(home, irrigation, municipal, industrial)

WELL COMPLETION DATA:

- (1) diameter (inches) 2"
- (2) total depth (feet) 126 ft.
- (3) static water level (feet) 20' below above top of ground.
- (4) casing PVC, 116,
(material) (depth)
 if telescope see back.
(size)
- (5) screen 10', 116'
(length) (depth to top)
2", PVC,
(size) (material)
- (6) pump 1, 8
(HP) (yield gpm)
electric
(type power)
- (7) electric log
(yes or no)

(organization running log)

(8) how well bottom plugged Sand

DRILLERS REMARKS: Shank


DEPT. OF NATURAL RESOURCES
BUREAU OF LAND & WATER RESOURCES

AUG 15 1983

RECEIVED

If well telescopes please sketch and show depths.

GROUND LEVEL

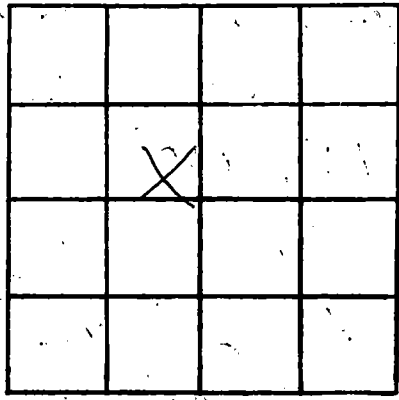

SECTION 7

Please indicate well location X.

ADDITIONAL INFORMATION

Lined area for additional information.

If more than one screen, show locations of each on sketch.