

MISSISSIPPI DEPARTMENT OF NATURAL RESOURCES

Bureau of Land and Water Resources

Southport Mall

P.O. Box 10631

Jackson, Mississippi 39209

WATER WELL DRILLERS LOG

**CODED**

G.395
HARRISON
11-25-83

11/25/83 date well completed      Lyman Well Co firm name      Harrison county well located

LANDOWNER: Winston Gaines  
Rt. 2, Box 82-43  
Saucier 39574  
 (mailing address)

description of formations encountered	depth	
	from	to
white clay	0	20
yellow sand	20	60
clay	60	90
good sand	90	124

WELL LOCATION:  
 sec. 21 T. 6 N. R. 11 E.  
20 miles (distance) N of Spot (direction) of (nearest town)

WELL PURPOSE: home  
 (home, irrigation, municipal, industrial)

WELL COMPLETION DATA:

(1) diameter (inches) 2"

(2) total depth (feet) 124'

(3) static water level (feet) 55' below top of ground. above

(4) casing PVC (material), 114' (depth), 2" (size) if telescope see back.

(5) screen 10' (length), 114' (depth to top), 2" (size), PVC (material)

(6) pump 1 (HP), 12 (yield gpm), electric (type power)

(7) electric log No (yes or no), No (organization running log)

(8) how well bottom plugged sand shark

DEPT. OF NATURAL RESOURCES  
 BUREAU OF LAND & WATER RESOURCES


APR 30 1984

**RECEIVED**

DRILLERS REMARKS:

If well telescopes please sketch and show depths.

GROUND LEVEL

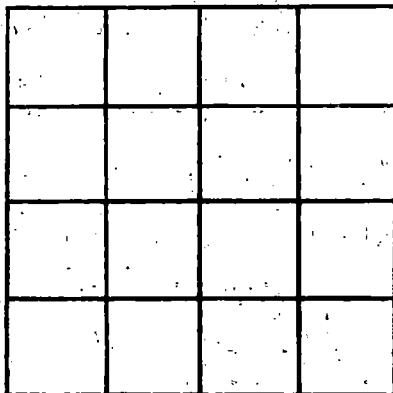

SECTION \_\_\_\_\_

Please indicate well location X.

ADDITIONAL INFORMATION

If more than one screen,  
show locations of each on sketch.