

MISSISSIPPI DEPARTMENT OF NATURAL RESOURCES

Bureau of Land and Water Resources

Southport Mall

P.O. Box 10631

Jackson, Mississippi 39209

WATER WELL DRILLERS LOG

G397  
 HARRISON  
 3-24-83

Lyman Well Harrison  
 firm name county well located

3/24/83  
 date well completed

LANDOWNER: J. Robert Lorton  
 Rt. 3, Box 560-G  
 Gulfport 39503  
 (mailing address)

Description of formations encountered	from	to
Gravel	0	15
Red Clay & Clay	15	102
Gumbo Clay		
Five Sand & Clay	102	173
Mixed		
Blue Clay	173	260
Red Sand	260	278
Blue Clay	278	346
Five Sand	346	415
Wood Sand	415	453

WELL LOCATION:  
 sec. 30 T. 6 N. R. 11 E.  
 11 miles N of Gpt  
 (distance) (direction) (nearest town)

WELL PURPOSE: HOME  
 (home, irrigation, municipal, industrial)

WELL COMPLETION DATA:

(1) diameter (inches) 2"

(2) total depth (feet) 453'

(3) static water level (feet) 70 below top of ground.

(4) casing PVC 443'  
 (material) (depth)  
 2" (size) if telescope see back.

(5) screen 10' 443'  
 (length) (depth to top)  
 2" PVC  
 (size) (material)

(6) pump 1 (HP) 11 (yield gpm)  
 electric (type power)

(7) electric log NO (yes or no)  
 NO (organization running log)

(8) how well bottom plugged sand shark

DEPT. OF NATURAL RESOURCES  
 BUREAU OF LAND & WATER RESOURCES


MAY 11 1983

RECEIVED

DRILLERS REMARKS:

If well telescopes please sketch and show depths.

GROUND LEVEL

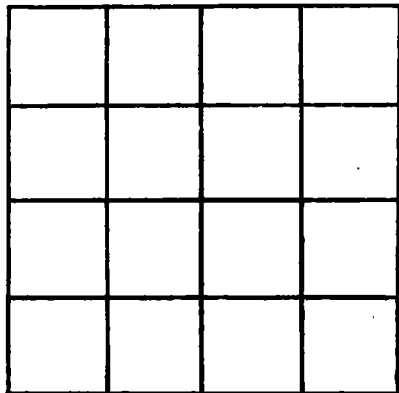

SECTION \_\_\_\_\_

Please indicate well location X.

ADDITIONAL INFORMATION

If more than one screen, show locations of each on sketch.