

MISSISSIPPI DEPARTMENT OF NATURAL RESOURCES

Bureau of Land and Water Resources


Southport Mall

P.O. Box 10631

Jackson, Mississippi 39209

WATER WELL DRILLERS LOG

G 398  
HARRISON  
3-27-84

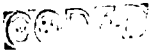

3-27-84 date well completed  
Bradley Pump Well firm name  
Harrison county well located

LANDOWNER: Joe Fernald  
Kellogg Rd.  
Aucier, Mo. 39574  
(mailing address)

WELL LOCATION:  
sec. 8 T. 6 S. R. 11 E.  
2 miles north of Lyna  
(distance) (direction) (nearest town)

WELL PURPOSE: home  
(home, irrigation, municipal, industrial)

WELL COMPLETION DATA:

- (1) diameter (inches) 4" x 2"
- (2) total depth (feet) 640
- (3) static water level (feet) 33 below top of ground.
- (4) casing PVC, 620 (material) (depth)
- 4 x 2 (size) If telescope see back.
- (5) screen 10' (length) 620 (depth to top)
- 2" PVC underbar (size) (material)
- (6) pump 1 1/2 (HP) 25 (yield gpm)
- 230V (type power)
- (7) electric log NO (yes or no)
- (organization running log)
- (8) how well bottom plugged PVC sandstone

description of formations encountered	from	to
Clay + Sand	0	20
Sand	20	40
Sand	40	60
stay sand	60	80
clay	80	100
clay	100	120
clay	120	140
clay	140	160
clay	160	180
Clay	180	200
Clay	200	220
clay	220	240
Sand	240	260
Sand	260	280
Clay	280	300
Clay + SB	300	320
sand	320	340
Sand	340	360
sand	360	380
blue clay	380	400
clay	400	420
Sand	420	440
Clay + sand	440	460
Sand	460	480
Clay	480	500
Clay	500	520
clay	520	540
clay + sand	540	560
clay	560	580
sand	580	600
sand	600	620
sand	620	640

DEPT. OF NATURAL RESOURCES  
BUREAU OF LAND & WATER RESOURCES

MAY 21 1984

RECEIVED

DRILLERS REMARKS: 10 ft tailpipe

If well telescopes please sketch and show depths.


GROUND LEVEL

200' 4" PVC

440' 2" PVC

101' x 2" PVC screen

15' tailpipe

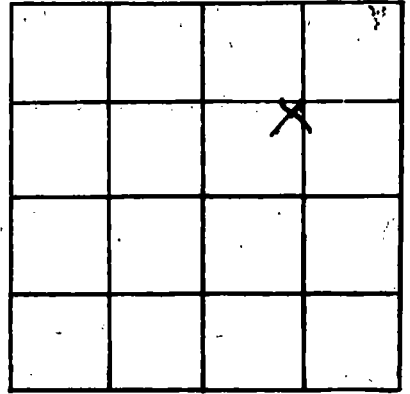

SECTION 8

Please indicate well location X.

ADDITIONAL INFORMATION

If more than one screen, show locations of each on sketch.