

G399

~~C25A~~

HARRISON

2-19-83

MISSISSIPPI DEPARTMENT OF NATURAL RESOURCES

Bureau of Land and Water Resources

Southport Mall

P.O. Box 10631

Jackson, Mississippi 39209

WATER WELL DRILLERS LOG

CODED

2/19/83
date well completed

Lyman Well
firm name

Harrison
county well located

LANDOWNER:

Wayne Geiger

description of formations encountered

from

to

Rt. 3, Box 141

Gulfport 39503
(mailing address)

Sand + Gravel	0	20
yellow clay	20	80
yellow sand	80	140
Blue clay	140	219
Salt + Pepper sand	215	252

WELL LOCATION:

sec. 28 T. 6 N. R. 11 E. S. 9 W. Gpt
(distance) miles (direction) of (nearest town)

WELL PURPOSE:

None
(home, irrigation, municipal, industrial)

WELL COMPLETION DATA:

- (1) diameter (inches) 4"
- (2) total depth (feet) 252'
- (3) static water level (feet) 52' below
top of ground. above
- (4) casing PVC, 242'
(material), (depth)
4"
(size) If telescope see back.
- (5) screen 10', 242'
(length), (depth to top)
4", PVC
(size), (material)
- (6) pump 1, 25
(HP), (yield gpm)
electric
(type power)
- (7) electric log NO
(yes or no)
NO
(organization running log)
- (8) how well bottom plugged sand
shark

DEPT. OF NATURAL RESOURCES
BUREAU OF LAND & WATER RESOURCES


MAY 11 1984

RECEIVED

DRILLERS REMARKS:

If well telescopes please sketch and show depths.

GROUND LEVEL

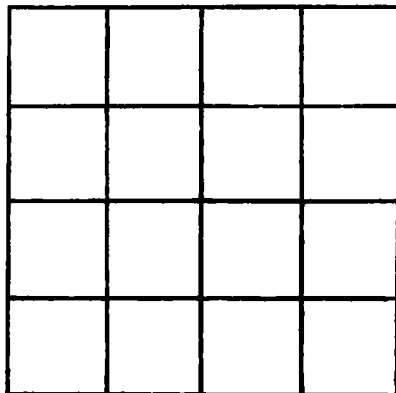

SECTION _____

Please indicate well location X.

ADDITIONAL INFORMATION

If more than one screen, show locations of each on sketch.