

MISSISSIPPI DEPARTMENT OF NATURAL RESOURCES

Bureau of Land and Water Resources

Southport Mall

P.O. Box 10631

Jackson, Mississippi 39209

CODED

WATER WELL DRILLERS LOG

~~1641~~ G400
 HARRISON
 3-26-84

3-26-84
 date well completed

McNiel Well Works
 firm name

Harrison
 county well located

LANDOWNER: Mayfield
Rt. 1 Box 127 M
Southport, Mo.
 (mailing address)

WELL LOCATION:
 sec 32 T 7 N R 11 E
8 miles N of Rept
 (distance) (direction) (nearest town)

WELL PURPOSE:
 (home, irrigation, municipal, industrial)

WELL COMPLETION DATA:
 (1) diameter (inches) 2"
 (2) total depth (feet) 250'
 (3) static water level (feet) 50' ^{below} above
 top of ground.
 (4) casing sch 40 sch 40
 (material) (depth)
 (size) If telescope see back.
 (5) screen 10' 240'
 (length) (depth to top)
2" sch 40
 (size) (material)
 (6) pump 1 10
 (HP) (yield gpm)
elec
 (type power)
 (7) electric log _____
 (yes or no)

 (organization running log)
 (8) how well bottom plugged Sand
Seal

description of formations encountered	from	to
Sand	0	40
mud	40	180
Sand	180	200
mud	200	220
Sand	220	250


DEPT. OF NATURAL RESOURCES
 BUREAU OF LAND & WATER RESOURCES

JUN - 1 1984
 RECEIVED

DRILLERS REMARKS:

If well telescopes please sketch and show depths.

GROUND LEVEL

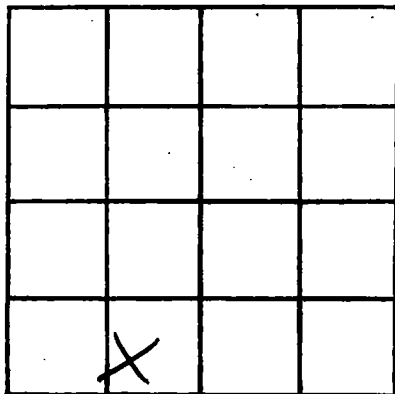

SECTION _____

Please indicate well location X.

ADDITIONAL INFORMATION

If more than one screen, show locations of each on sketch.