

MISSISSIPPI DEPARTMENT OF NATURAL RESOURCES

Bureau of Land and Water Resources

Southport Mall

P.O. Box 10631

Jackson, Mississippi 39209

WATER WELL DRILLERS LOG

CODED

HARRISON

G 401

8/13/1984

Bradley Pump & Well Dr., Inc.

Harrison

date well completed

firm name

county well located

LANDOWNER: Curt Wasyk

description of formations encountered

from

to

Cox Rd.

red clay

0

35

Gulfport, Ms. 39503  
(mailing address)

red sand

35

60

blue clay

60

110

blue clay + sand

110

120

blue blue clay

120

150

grey sand

150

180

blue clay

180

220

WELL LOCATION:

sec. 36 T. 6 S. R. 11 E. W. 6  
6 miles east of Lyna  
(distance) (direction) (nearest town)

WELL PURPOSE: Home  
(home, irrigation, municipal, industrial)

WELL COMPLETION DATA:

- (1) diameter (inches) 2"
- (2) total depth (feet) 220'
- (3) static water level (feet) 24 below static top of ground.
- (4) casing PVC, 170  
(material) (depth)  
2"  
(size) If telescope see back.
- (5) screen 10 ft., 170  
(length) (depth to top)  
2", PVC  
(size) (material)
- (6) pump 1, 10  
(HP) (yield gpm)  
230 volt  
(type power)
- (7) electric log no  
(yes or no)

CODED

DEPT. OF NATURAL RESOURCES  
BUREAU OF LAND & WATER RESOURCES

AUG 16 1984

RECEIVED


DRILLERS REMARKS: 40 ft  
tailpipe

(organization running log)

(8) how well bottom plugged PVC  
sandbar

If well telescopes please sketch and show depths.

GROUND LEVEL

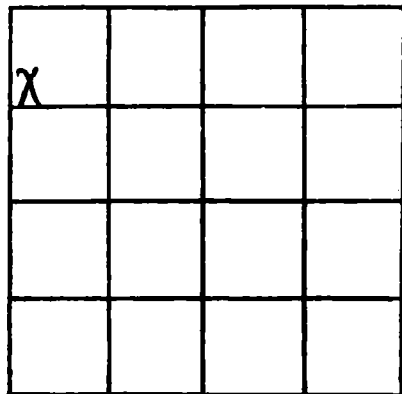

SECTION 36

Please indicate well location X.

ADDITIONAL INFORMATION

If more than one screen, show locations of each on sketch.