

MISSISSIPPI DEPARTMENT OF NATURAL RESOURCES

Bureau of Land and Water Resources

Southport Mall

P.O. Box 10631

Jackson, Mississippi 39209

WATER WELL DRILLERS LOG

CODED

HARRISON

G 402

6/29/84

6/29/84
date well completed

19 Lyman Well Co.
firm name

Harrison
county well located

LANDOWNER: D.W. Allan

July 53

Southport, MS 39503
(mailing address)

WELL LOCATION:

sec. 20 T 6 N R. 11 E
9 miles N of SA
(distance) (direction) (nearest town)

WELL PURPOSE: ED MO
(home, irrigation, municipal, industrial)

WELL COMPLETION DATA:

- (1) diameter (inches) 2"
- (2) total depth (feet) 360'
- (3) static water level (feet) 70' below top of ground.
- (4) casing PVC, 350' (depth)
- 2" (size) if telescope see back.
- (5) screen 10' (length), 350' (depth to top)
- 2" (size) PVC (material)
- (6) pump N/A (HP), N/A (yield gpm)
- NA (type power)
- (7) electric log NO (yes or no)
- NO (organization running log)
- (8) how well bottom plugged sand shark

description of formations encountered

from to

Red Clay fine sand	0	40
Medium Sand Sand Gravel	40	100
White & Blue Gumbo	100	240
Red fine sand	240	260
Blue clay Gumbo	260	325
Coarse Sand	325	360

CODED


DEPT. OF NATURAL RESOURCES
BUREAU OF LAND & WATER RESOURCES

SEP - 5 1984
RECEIVED

DRILLERS REMARKS:

If well telescopes please sketch and show depths.

GROUND LEVEL

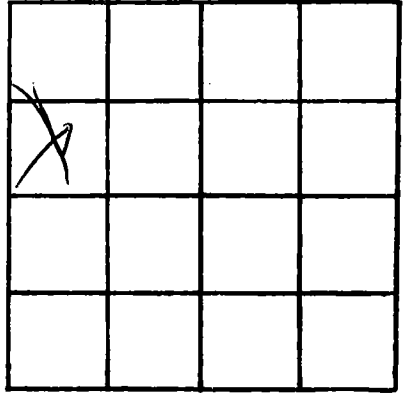

SECTION 20

Please indicate well location X.

ADDITIONAL INFORMATION

If more than one screen,
show locations of each on sketch.