

MISSISSIPPI DEPARTMENT OF NATURAL RESOURCES

Bureau of Land and Water Resources

Southport Mall

P.O. Box 10631

Jackson, Mississippi 39209

WATER WELL DRILLERS LOG

CODED

HARRISON
G 403
1/16/84

1/16/84 date well completed 19 Lymax Well Co. firm name Harrison county well located

LANDOWNER: Bobby Clark
Rt. 3
Gulfport, Md 39503
(mailing address)

description of formations encountered	from	to
<u>Red & Yellow Clay</u>	<u>0</u>	<u>60</u>
<u>Green & Blue Gumbo</u>	<u>60</u>	<u>180</u>
<u>Fine Sand & Clay Mined</u>	<u>180</u>	<u>240</u>
<u>Blue Gumbo</u>	<u>240</u>	<u>400</u>
<u>Fine Sand</u>	<u>400</u>	<u>420</u>
<u>Wood Sand</u>	<u>420</u>	<u>484</u>

WELL LOCATION:
sec. 27 T. 6 N R. 11 E
13 miles N/E of G.P.T.
(distance) (direction) (nearest town)

WELL PURPOSE: Home
(home irrigation, municipal, industrial)

CODED

- WELL COMPLETION DATA:
- (1) diameter (inches) 4x2
 - (2) total depth (feet) 484
 - (3) static water level (feet) 84' below top of ground.
 - (4) casing PVC, 464'
(material) (depth)
4x2 If telescope see back.
(size)
 - (5) screen 20', 464'
(length) (depth to top)
2", PVC
(size) (material)
 - (6) pump 1/2, 35
(HP) (yield gpm)
electric
(type power)
 - (7) electric log No
(yes or no)
No
(organization running log)
 - (8) how well bottom plugged sand
shark

DEPT. OF NATURAL RESOURCES
BUREAU OF LAND & WATER RESOURCES


SEP - 5 1984

RECEIVED

DRILLERS REMARKS:

If well telescopes please sketch and show depths.

GROUND LEVEL

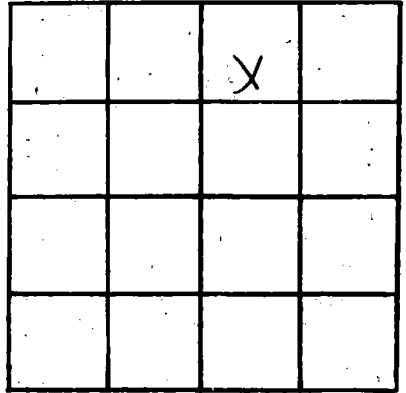

SECTION 27

Please indicate well location X.

ADDITIONAL INFORMATION

If more than one screen, show locations of each on sketch.