

MISSISSIPPI DEPARTMENT OF NATURAL RESOURCES

Bureau of Land and Water Resources

Southport Mall

P.O. Box 10631

CODED

Jackson, Mississippi 39209

WATER WELL DRILLERS LOG

6413
Harrison
9-26-84

9/26/84 19 Lyman Well Co Harrison
date well completed firm name county well located

Fountain of Life Tabernacle
Rt. 3, Box 148
Gulfport, Md 39503
(mailing address)


Description of formations encountered	from	to
yellow clay	0	10
blue clay	11	85
fine sand	86	120
blue clay	121	430
sand good	431	520
blue clay	521	570
sand & pea gravel	571	630

WELL LOCATION:
sec. 17 T. 6 N. R. 11 E.
10 miles N of Gpt
(distance) (direction) (nearest town)

WELL PURPOSE: apartment
(home, irrigation, municipal, industrial)


- WELL COMPLETION DATA:
- (1) diameter (inches) 4"
 - (2) total depth (feet) 650'
 - (3) static water level (feet) 63' below top of ground
 - (4) casing PVC 630' (material) (depth)
4" (size) If telescope see back.
 - (5) screen 20' 630' (length) (depth to top)
4" PVC (size) (material)
 - (6) pump 5 (HP) 10 (yield gpm)
electrical (type power)
 - (7) electric log No (yes or no)
No (organization running log)
 - (8) how well bottom plugged sand shark

DRILLERS REMARKS:

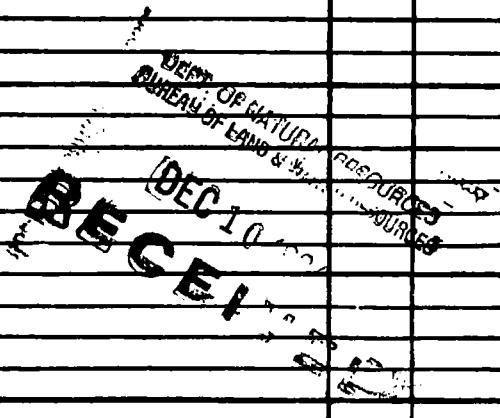

If well telescopes please sketch and show depths.

GROUND LEVEL

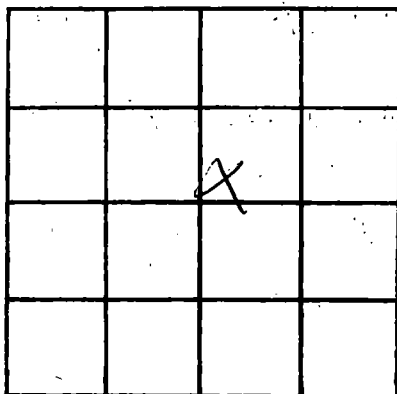

SECTION 17

Please indicate well location X.

ADDITIONAL INFORMATION

If more than one screen, show locations of each on sketch.