

MISSISSIPPI DEPARTMENT OF NATURAL RESOURCES
 Bureau of Land and Water Resources
 Southport Mall
 P.O. Box 10631
 Jackson, Mississippi 39209
WATER WELL DRILLERS LOG

CODED

Harrison
 G 420
 2/18/85

2/18/85
 date well completed

19 Lyman Well Co.
 firm name

Harrison
 county well located

LANDOWNER:

Jerry L Allen
 Rt. 10, Box 329
 Gulfport, Miss 39503
 (mailing address)

description of formations encountered

from to

Red sand	0	60
white clay	60	80
gray clay	60	80
fine sand	80	190
fine sand	190	200
Blue clay	200	455
coarse sand	455	480

WELL LOCATION:

sec. 34 T. 6 N. R. 11 E
 5 miles N.E. of Gulfport
 (distance) (direction) (nearest town)

WELL PURPOSE:

home
 (home, irrigation, municipal, industrial)

WELL COMPLETION DATA:

- (1) diameter (inches) 2"
- (2) total depth (feet) 490'
- (3) static water level (feet) 61' below top of ground
- (4) casing PVC, 480' (material) (depth)
- 2" (size) if telescope see back.
- (5) screen 10', 480' (length) (depth to top)
- 2" PVC (size) (material)
- (6) pump N/A (HP) (yield gpm)

CODED

RECEIVED

MAY 24 1985


- (7) electric log No (yes or no)
- NO (organization running log)
- (8) how well bottom plugged sand shack

DRILLERS REMARKS:

Department of Natural Resources
 Bureau of Land & Water Resources

If well telescopes please sketch and show depths.

GROUND LEVEL

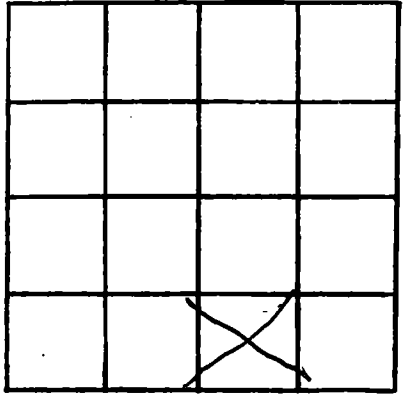

SECTION ~~20~~ 34

Please indicate well location X.

ADDITIONAL INFORMATION

A series of horizontal lines for writing additional information.

If more than one screen, show locations of each on sketch.