

MISSISSIPPI DEPARTMENT OF NATURAL RESOURCES

Bureau of Land and Water Resources

Southport Mall

P.O. Box 10631

Jackson, Mississippi 39209

WATER WELL DRILLERS LOG

CODED

Harrison
G421
3/8/85

3-8
date well completed

19 85 Mc Hill Well
firm name

Harrison
county well located

LANDOWNER: Miller & Sons
1207 Westeria Lane
Long Beach Ms. 39560
(mailing address)

WELL LOCATION:
sec. 19 T-6 N R-11 E
2 miles W of LYMAN
(distance) (direction) (nearest town)

WELL PURPOSE:
(home, irrigation, municipal, industrial)

WELL COMPLETION DATA:

- (1) diameter (inches) 2"
- (2) total depth (feet) 500'
- (3) static water level (feet) 60' ^{below} _{above} top of ground.
- (4) casing SP40 PVC, 490'
(material) (depth)
 if telescope see back.
(size)
- (5) screen 10', 490'
(length) (depth to top)
2", Sch. 80 6 slot
(size) (material)
- (6) pump 1 8
(HP) (yield gpm)

ELEC.
(type power)

(7) electric log
(yes or no)

(organization running log)

(8) how well bottom plugged SAND
SHARK

description of formations encountered	from	to
Mud	0	20
Mud/Sand	20	40
Sand	40	60
Sand	60	80
Sand/Mud	80	100
Mud	100	120
Mud/Sand	120	140
Mud/Sand	140	160
Sand/Mud	160	180
Mud	180	200
Mud	200	220
Mud	220	240
Mud	240	260
Mud	260	280
Mud	280	300
Mud	300	320
Mud	320	340
Mud	340	360
Mud	360	380
Mud	380	400
Mud/Sand	400	420
Sand	420	440
Sand	440	460
Sand	460	480
Sand	480	500

CODED


RECEIVED
JUN - 4 1985

DRILLERS REMARKS:

Department of Natural Resources
Bureau of Land & Water Resources

If well telescopes please sketch and show depths.

GROUND LEVEL

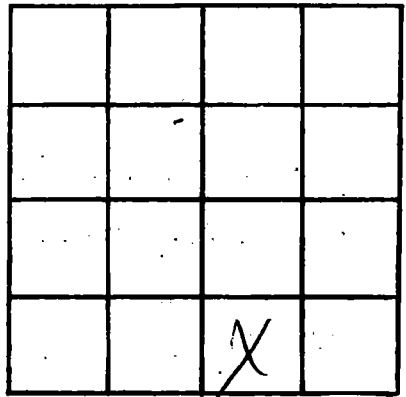

SECTION _____

Please indicate well location X.

ADDITIONAL INFORMATION

Lined area for additional information.

If more than one screen, show locations of each on sketch.