

MISSISSIPPI DEPARTMENT OF NATURAL RESOURCES

Bureau of Land and Water Resources

Southport Mall

P.O. Box 10631

Jackson, Mississippi 39209

WATER WELL DRILLERS LOG

CODED

HARRISON

G 422

5/21/85
date well completed

Lyman Well Co
firm name

Harrison
county well located

LANDOWNER:

Carl Jamison

description of formations encountered

from

to

Rt. 3, Box 124
Gulfport, Miss 39503
(mailing address)

Red clay
gray clay
SAND GRASS

0	40
40	430
430	460

WELL LOCATION:

sec 21 T 6 N R 11 E
S W
3 miles east of LYMAN
(distance) (direction) (nearest town)

CODED

WELL PURPOSE:

(home, irrigation, municipal, industrial)

WELL COMPLETION DATA:

- (1) diameter (inches) 4x2
- (2) total depth (feet) 460'
- (3) static water level (feet) 68' ^{below} _{above} top of ground.
- (4) casing PVC 430'
(material) (depth)
4x2 If telescope see back.
(size)
- (5) screen 30' 430'
(length) (depth to top)
2" PVC
(size) (material)
- (6) pump 1 1/2 35
(HP) (yield gpm)
electric
(type power)
- (7) electric log No
(yes or no)
No
(organization running log)
- (8) how well bottom plugged sand
shark

RECEIVED



AUG 20 1985

DRILLERS REMARKS:

Department of Natural Resources
Bureau of Land & Water Resources

If well telescopes please sketch and show depths.

GROUND LEVEL

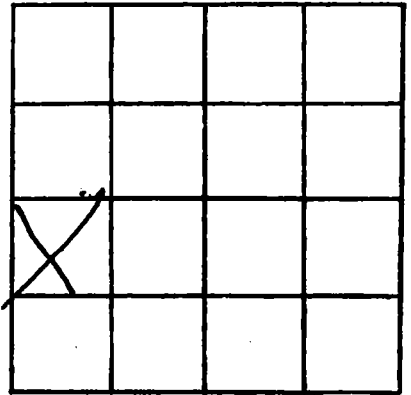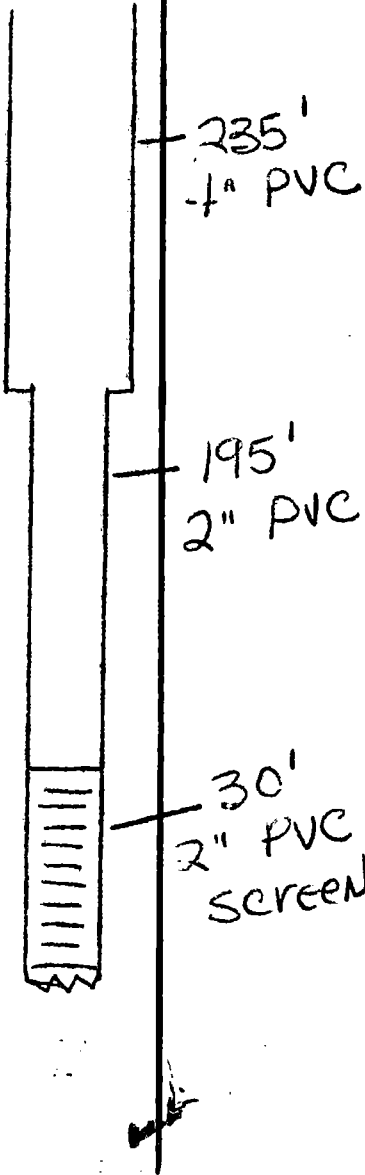

SECTION 21

Please indicate well location X.

ADDITIONAL INFORMATION

If more than one screen, show locations of each on sketch.