

MISSISSIPPI DEPARTMENT OF NATURAL RESOURCES

Bureau of Land and Water Resources

Southport Mall

P.O. Box 10631

Jackson, Mississippi 39209

WATER WELL DRILLERS LOG CODED

HARRISON  
G423  
10-4-85

Oct 4, 1985 date well completed      Braden Pump & Well Ser. Harrison firm name      county well located

LANDOWNER: Miss. State Hwy Dept.  
Rt. #1 Box 678, Saucier MS  
(mailing address)

WELL LOCATION: sec. 17 T 6 N R 11 E  
2 miles N of Lyman  
(distance) (direction) (nearest town)

WELL PURPOSE: (home, irrigation, municipal, industrial)

WELL COMPLETION DATA:  
(1) diameter (inches) 4" X 2"  
(2) total depth (feet) 980  
(3) static water level (feet) 4 ~~980~~ above top of ground.  
(4) casing Steel 940, 4" X 2" (material), (depth), (size) If telescope see back.  
(5) screen 20ft. 940, 2" Stainless Steel (length), (depth to top), (size), (material)  
(6) pump 1 1/2 20, 220V 1 phase (HP), (yield gpm), (type power)  
(7) electric log No (yes or no) (organization running log)  
(8) how well bottom plugged

description of formations encountered	from	to
Surface	0	6
Brown Clay	6	18
White Sand	18	26
Gray Clay	26	42
White Clay	42	84
Blue Clay	84	226
Grey fine Sand & cly.		
Breaks CODED	226	332
Grey Sand	332	385
Blue Clay	385	618
Grey fine Sand	618	624
Blue Clay	624	744
Grey fine Sand	744	748
Blue Clay	748	852
Sand Break	852	858
Blue Clay	858	880
Grey fine Sand	880	930
Medium Grey Sand	930	960
Blue Clay	960	980+


RECEIVED  
NOV - 7 1985

Department of Natural Resources  
Bureau of Land & Water Resources

DRILLERS REMARKS:

If well telescopes please sketch and show depths.

GROUND LEVEL

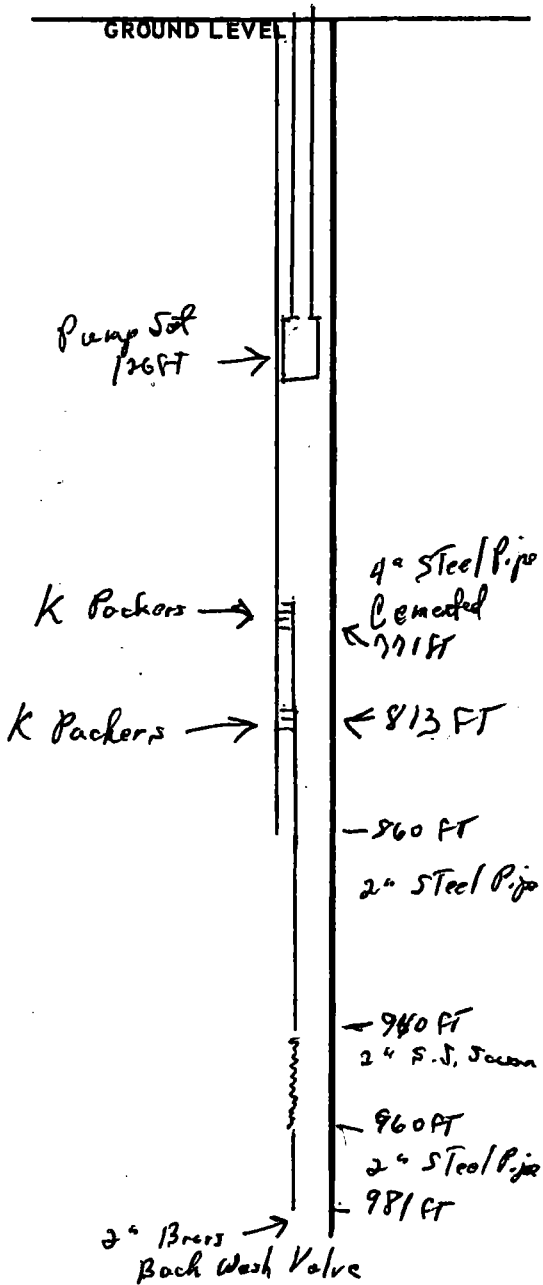

		X	

SECTION 17

Please indicate well location X.

ADDITIONAL INFORMATION

If more than one screen, show locations of each on sketch.