

**MISSISSIPPI DEPARTMENT OF NATURAL RESOURCES**

Bureau of Land and Water Resources

COUNTY WELL LOCATED <i>Harrison</i>	
WELL NUMBER <i>G 426</i>	CODED
DATE WELL COMPLETED <i>5/15/87</i>	

PERMIT NUMBER
NAME OF DRILLING FIRM <i>Lizman Well Co</i>

P.O. Box 10631  
Jackson, Mississippi 39209  
**WATER WELL DRILLERS LOG**

**CODED**

NAME & MAILING ADDRESS OF LANDOWNER <i>Randy Brownlee</i>			
<i>121 Gahan Dr.</i>			
<i>Gulfport, MS 39503</i>			
WELL LOCATION	SEC	TOWNSHIP	RANGE
	<i>31</i>	<i>6 N</i>	<i>11 E</i>
DISTANCE	DIRECTION	NEAREST TOWN	
<i>6</i> Miles	<i>North</i>	<i>Gulfport</i>	
OTHER LANDMARK			
WELL PURPOSE: Home, Irrigation, Municipal, Industrial, Fish Pond, etc. <i>0</i>			

<b>PUMP DATA</b>		
PUMP TYPE (Circle One): <i>Submersible</i> , Turbine, Jet, Flowing Well, Other (Describe)		
POWER TYPE (Circle One): <i>Electric</i> , Tractor, Diesel, Gasoline, Butane, Other (Describe)		
Pump Capacity (GPM) <i>20</i>	No. of Stages <i>11</i>	Setting Depth <i>120'</i> FT.
PUMP TEST		
Well yielded <b>CODED</b> GPM with a drawdown of _____ ft. after _____ hours of pumping		

<b>WELL DATA</b>		
Well Depth <i>700'</i>	Casing Diameter (In.) <i>4x2</i>	Casing Length (Ft.) <i>680'</i>
Type of Casing <i>PVC</i>	Hole Depth <i>700'</i>	Depth to Static Water Level <i>80'</i>
TYPE OF COMPLETION: (Circle One or More): <i>Natural Development</i> , Gravel Packed, Underreamed, Telescoped, Open Hole, Other (Describe)		
Top of Lap Pipe or Reduction in Casing <i>240 FEET</i>		
IF TELESCOPED OR MORE THAN ONE SCREEN: USE BACK PAGE		

<b>LOG DATA</b>	
TYPE OF LOG RUN (Circle One): <i>No Log Run</i> , Electric, Gamma Ray, Density, Sonic, Neutron, Other (Describe)	
Name of Organization Running Log	

<b>SCREEN DATA</b>		
Diameter - Inches <i>2</i>	Length - Feet <i>20</i>	Slot Size - Inches
Screen Type <i>PVC Sawn</i>	Depth to Bottom - Feet <i>700'</i>	

<b>GEOLOGIC DATA (Office Use Only)</b>			
Surface Elev.	Geologic Unit	Unit Thickness	Depth to Top
Subs. SWL	Date	Analysis	Aquifer Test

Driller's Remarks <i>None</i>
----------------------------------

**RECEIVED**



DESCRIPTION OF FORMATIONS ENCOUNTERED	FROM	TO	FORMATION (Continued)	TO
<i>Topsoil</i>		<i>1'</i>		
<i>Yellow &amp; White Clay</i>	<i>1'</i>	<i>23'</i>		
<i>Sand</i>	<i>23'</i>	<i>31'</i>		
<i>Blue Clay</i>	<i>31'</i>	<i>215'</i>		
<i>Sandy Clay</i>	<i>215'</i>	<i>239'</i>		
<i>Clay</i>	<i>239'</i>	<i>420'</i>		
<i>Sand</i>	<i>420'</i>	<i>461'</i>		
<i>Clay</i>	<i>461'</i>	<i>664'</i>		
<i>Sand</i>	<i>664'</i>	<i>700'</i>		

AUG 25 1987

Department of Natural Resources  
Bureau of Land & Water Resources

IF MORE SPACE IS NEEDED, USE BACK

If well telescopes please sketch and show depths.

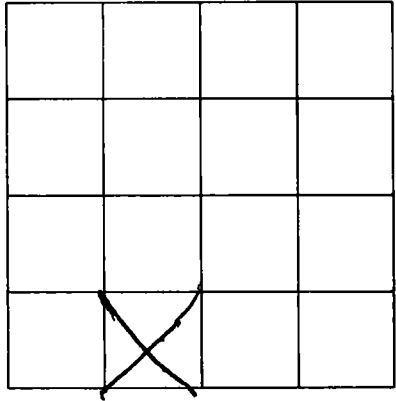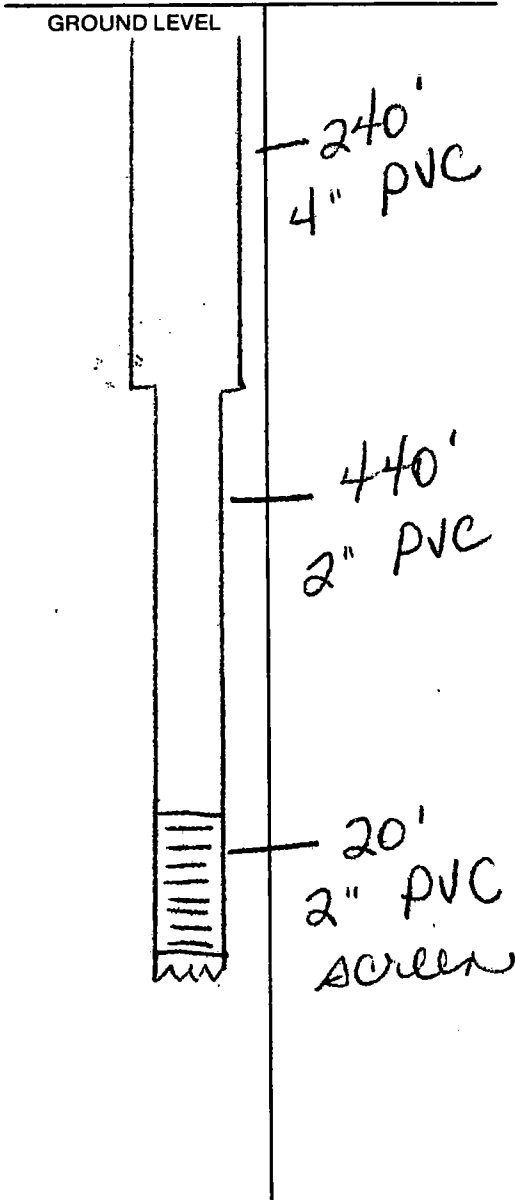

SECTION 31

Please indicate well location X.

ADDITIONAL INFORMATION

Multiple horizontal lines for additional information.

If more than one screen, show location of each on sketch.