

Need correct #

MISSISSIPPI DEPARTMENT OF ENVIRONMENTAL QUALITY

Office of Land and Water Resources

P. O. Box 10631
Jackson, MS 39289-0631
WATER WELL DRILLERS LOG

COUNTY WELL LOCATED <i>Harrison</i>		
WELL NUMBER <i>G 433</i>	CODED	PERMIT NUMBER
NAME OF DRILLING FIRM <i>Coast Water Well Service</i>		
DATE WELL COMPLETED <i>12-23-94</i>		

NAME & MAILING ADDRESS OF LANDOWNER
Braden Pump & Well
Hwy 49
Gulfport, Ms

WELL LOCATION SEC TOWNSHIP RANGE
SE 20 6 N 11 W

DISTANCE DIRECTION NEAREST TOWN
6 Miles *NORTH* of *GULFPORT*

OTHER LANDMARK

WELL PURPOSE Home Irrigation, Municipal, Industrial, Fish Pond, etc.

PUMP DATA

PUMP TYPE (Circle One):
Submersible, Turbine, Jet, Flowing Well, Other (Describe)

POWER TYPE (Circle One):
Electric, Tractor, Diesel, Gasoline, Butane, Other (Describe) H/P

Pump Capacity (GPM) No. of Stages Setting Depth FT.

PUMP TEST

Well yielded _____ GPM with a drawdown of _____ ft. after _____ hours of pumping

WELL DATA

Well Depth <i>660'</i>	Casing Diameter (In.) <i>4" x 2"</i>	Casing Length (Ft.) <i>640'</i>
Type of Casing <i>PVC</i>	Hole Depth <i>660'</i>	Depth to Static Water Level

TYPE OF COMPLETION: (Circle One or More):
 Gravel Packed, Underreamed, Telescoped, Natural Development, Open Hole, Other (Describe)

WELL GROUTED TO A DEPTH OF *20* FEET
Type Grout (circle one): Cement, Bentonite, or Mix

LOG DATA

TYPE OF LOG RUN (Circle One):
Electric, Gamma Ray, Density, Sonic, Neutron, Other (Describe) No Log Run

Name of Organization Running Log

SCREEN DATA

Diameter - Inches <i>2"</i>	Length - Feet <i>20'</i>	Slot Size - Inches <i>.008</i>
Screen Type <i>PVC</i>	Depth to Bottom - Feet <i>660'</i>	

GEOLOGIC DATA (Office Use Only)

Surface Elev.	Geologic Unit	Unit Thickness	Depth to Top
Subs. SWL	Date	Analysis	Aquifer Test

Driller's Remarks

Top of Lap Pipe or Reduction in Casing

FEET IF TELESCOPED OR MORE THAN ONE SCREEN: USE BACK PAGE


DESCRIPTION OF FORMATIONS ENCOUNTERED	FROM	TO
<i>Top Soil</i>	<i>0</i>	<i>2</i>
<i>Orange & Grey Clay</i>	<i>2</i>	<i>65</i>
<i>Medium Sand</i>	<i>65</i>	<i>75</i>
<i>Blue Clay & Strucky Sand</i>	<i>75</i>	<i>175</i>
<i>Medium Sand</i>	<i>175</i>	<i>185</i>
<i>Blue Clay & Strucky Sand</i>	<i>185</i>	<i>325</i>
<i>Coarse Sand</i>	<i>325</i>	<i>345</i>
<i>Blue Clay</i>	<i>345</i>	<i>410</i>
<i>Coarse Sand</i>	<i>410</i>	<i>518</i>
<i>Blue Clay</i>	<i>518</i>	<i>598</i>
<i>Med-Coarse Sand</i>	<i>598</i>	<i>660</i>

FORMATIONS (Continued)

FORMATIONS (Continued)	FROM	TO
RECEIVED		
JAN 11 1995		
Dept. of Environmental Quality Office of Land & Water Resources		

IF MORE SPACE IS NEEDED USE BACK

If well telescopes please sketch and show depths.

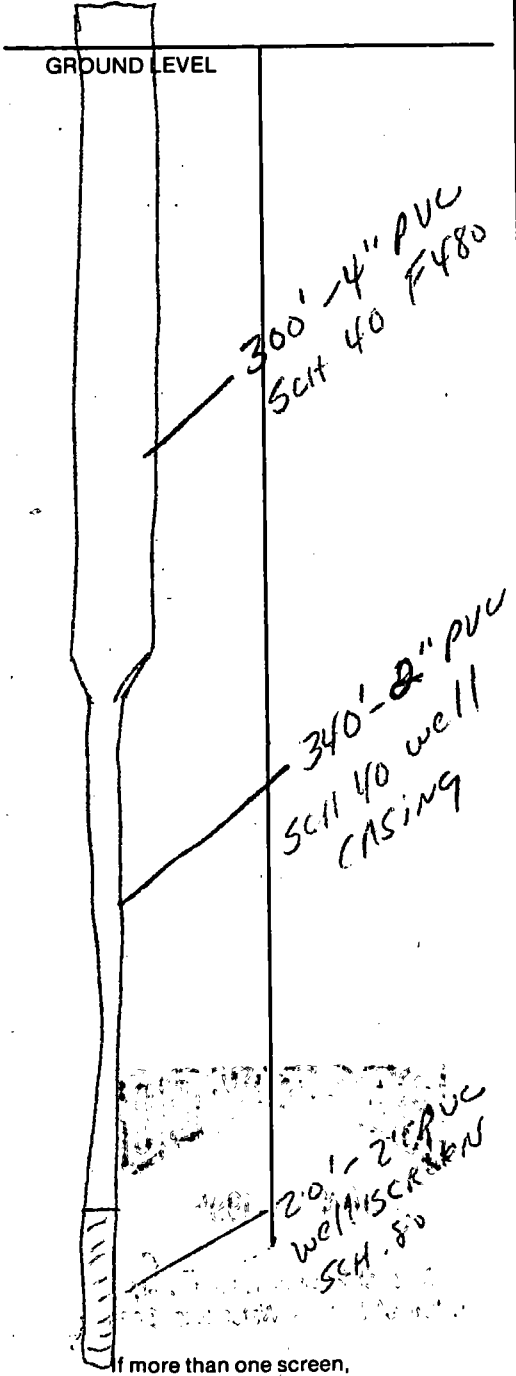

		X	

SECTION 20

Please indicate well location X.

ADDITIONAL INFORMATION

If more than one screen, show location of each on sketch.

[Handwritten signature]