

0-472

MISSISSIPPI DEPARTMENT OF ENVIRONMENTAL QUALITY
Bureau of Land and Water Resources

COUNTY WELL LOCATED
Harrison

WELL NUMBER
GA 10

DATE WELL COMPLETED
4-12-89

PERMIT NUMBER

Coastal Drilling & Service Co.
8456 Woolmarket Biloxi Road
Biloxi, Mississippi 39532

P. O. Box 10631
Jackson, MS 39289-0631
WATER WELL DRILLERS LOG

NAME & MAILING ADDRESS OF LANDOWNER
Gordon Smith
14205 Duchworth Rd.
Gulfport, Ms.

WELL LOCATION: SEC TOWNSHIP RANGE
Harrison 33 6 S 11 W

DISTANCE DIRECTION NEAREST TOWN
2 Miles *N* of *Tandem*

OTHER LANDMARK
Flat Branch

WELL PURPOSE (Home, Irrigation, Municipal, Industrial, Fish Pond, etc.)

PUMP DATA

PUMP TYPE (Circle One):
Submersible, Turbine, Jet, Flowing Well,
Other (Describe) _____

POWER TYPE (Circle One):
Electric, Tractor, Diesel, Gasoline, Butane,
Other (Describe) _____ H/P _____

Pump Capacity (GPM) No. of Stages Setting Depth
_____ FT.

PUMP TEST

Well yielded _____ GPM with
a drawdown of _____ ft.
after _____ hours of pumping

WELL DATA

Well Depth Casing Diameter (In.) Casing Length (Ft.)
260' *2"* *250'*

Type of Casing Hole Depth Depth to Static Water Level
PVC *260'* *45'*

TYPE OF COMPLETION: (Circle One or More):
Gravel Packed, Underreamed, Telescoped,
Natural Development, Open Hole, Other
(Describe) _____

Top of Lap Pipe or Reduction in Casing
FEET IF TELESCOPED OR MORE THAN ONE SCREEN: USE BACK PAGE

LOG DATA

TYPE OF LOG RUN (Circle One):
Electric, Gamma Ray, Density, Sonic, Neutron,
Other (Describe) _____

Name of Organization Running Log _____

SCREEN DATA

Diameter - Inches Length - Feet Slot Size - Inches
2" *10'* *.008"*

Screen Type Depth to Bottom - Feet
PVC *260'*

GEOLOGIC DATA (Office Use Only)

Surface Elev.	Geologic Unit	Unit Thickness	Depth to Top
Subs. SWL	Date	Analysis	Aquifer Test


Driller's Remarks
Did not install pump

DESCRIPTION OF FORMATIONS ENCOUNTERED	FROM	TO	FORMATIONS (Continued)	TO
<i>Top soil</i>	<i>1'</i>	<i>3'</i>	<div style="font-size: 2em; font-weight: bold; border: 2px solid black; padding: 5px; display: inline-block;">RECEIVED</div> FEB 24 1992 Dept. of Environmental Quality Bureau of Land & Water Resources	
<i>Red sand</i>	<i>3'</i>	<i>14'</i>		
<i>White sand</i>	<i>14'</i>	<i>30'</i>		
<i>soft Blue Clay</i>	<i>30'</i>	<i>180'</i>		
<i>fine water sand</i>	<i>180'</i>	<i>240'</i>		
<i>Coarse water sand</i>	<i>240'</i>	<i>260'</i>		

IF MORE SPACE IS NEEDED, USE BACK

If well telescopes please sketch and show depths.

GROUND LEVEL

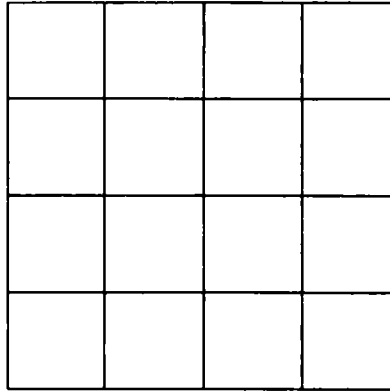

SECTION _____

Please indicate well location X.

ADDITIONAL INFORMATION

If more than one screen, show location of each on sketch.