

County: Harrison
 Permit #: 0239
 Driller: McGill Pump & Well
 Date drilling completed: 06/12/08

State Well Report
Part 1 - Driller's Log
 Mississippi Department of Environmental Quality
 Office of Land and Water Resources
 P.O. Box 10631
 Jackson, MS 39289-0631
 (601)961-5210
 (601)354-6938 (fax)

For Office Use Only:
 Aquifer: _____
 Well #: G-535
 L. S. Elevation: _____
 E-log #: _____

State Law requires that this report be prepared by the license holder responsible for the work and filed with the Department at the above address within 30 days of completion of drilling of the well or borehole.

Information on Well Owner (Landowner if borehole is not for a water well)	Well or Borehole Location
Owner Name: <u>Mr. Dunaway</u>	Latitude: _____ Longitude: _____
Mailing Address: <u>16495 Mellard Dr.</u>	Method of Lat/Long (circle one): Conventional Survey, USGS quad, Hand-held GPS, Survey-grade GPS
<u>Gpt. MS. 39503</u> City State Zip Code	<u>32</u> <u>65</u> <u>11 W</u> 1/4 1/4 Sec. Twn Rng
Telephone No. <u>(228) 832-3654</u>	Distance Direction Nearest Town <u>11</u> Miles <u>N</u> of <u>Gpt.</u>

Well / Borehole Data

Date drilling started: 04/10/08 Date drilling completed: 06/12/08 Hole depth: 380 Hole diameter: _____

Location of the source of any surface water used for drilling: Well @ office property

Method of dosing and volume of Chlorine used in drilling and development: _____

Logs run (circle all applicable): No log run Electric Gamma Ray Density Sonic Neutron Other: _____

Name of organization running log(s): _____

Purpose of borehole (check one): Water Well Geotechnical/Geological Investigation _____ Ground Source Heat Pump _____

Seismic Survey _____ Other (describe) _____

If drilling is not related to water well construction, skip the remainder of this block

Purpose of Well (check one): Home Industrial _____ Public Supply _____ Irrigation _____ Fish Culture _____ Other: _____

If a flowing well, method of flow regulation: Valve _____ Other (describe) _____

Static Water Level: 30 feet above or below (circle one) land surface Date measured: 06/12/08

Method of Measurement (circle one) steel tape electric tape air line other: _____

Well depth: 380 Well grouted to a depth of 10 feet Type of grout (circle one): Neat Cement Bentonite Mix

Casing length: 360 feet Casing diameter: 4 X 2 inches Type of casing: PVC

Screen length: 20 feet Screen diameter: 2 inches Type of screen: PVC

Screen slot size: .0006 inches Setting depth: From 360 feet to 380 feet

Type of completion (circle all applicable): Gravel packed Underreamed Telescoped Open hole Natural Development

Other (describe): _____

Top of lap pipe or reduction in casing: 20 feet. *If telescoped or more than one screen, describe on next page*

Form: OLWR-SWR-1A

RECEIVED
 JUL 02 2008
 BY: OLWR

The sketch below only required for water wells


Description of formations encountered must be provided for all wells and boreholes, unless specifically exempted by regulations.

G-535

If well telescopes, show depths on sketch.

Ground Level \longrightarrow


200 = 4"
180 = 2"

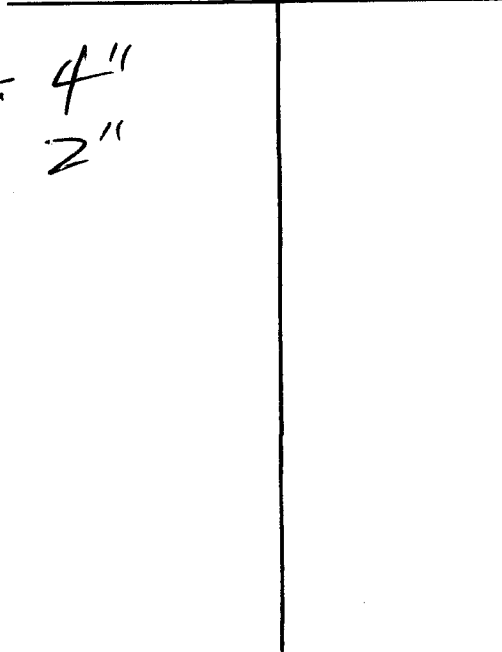

Description of Formations Encountered	From (depth)	To (depth)
Mid Blue	Ground Level	
Mid White	0	200
SAND Blue	200	320
	320	380

If more than one screen, show location of each on sketch

Sketch the property layout and include the following: 1) the well location; 2) any permanent structures on the property that may aid in locating the well; 3) any roads, power lines, or other items that may aid in locating the property and the well; 4) a north arrow.

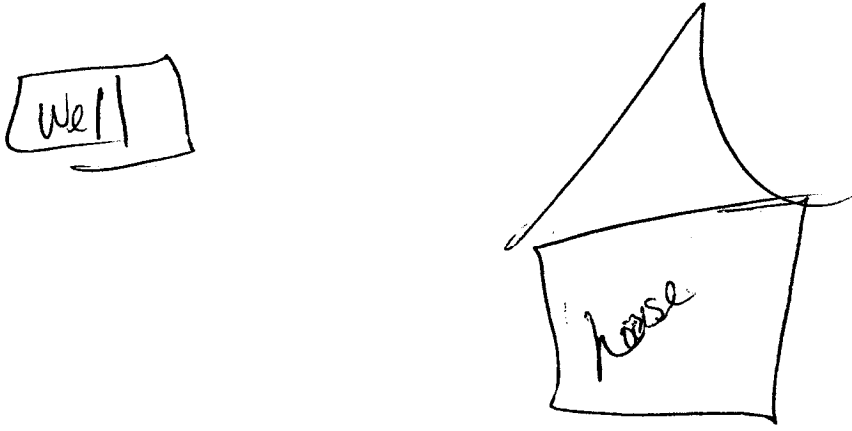

Landowner Name: Mr. Dunaway

Form: OLWR-SWR-1A

I certify that the well/borehole was drilled, constructed, and completed in accordance with all applicable requirements of the Mississippi Department of Environmental Quality and the Mississippi Department of Health regulations, if applicable, and state laws.

McGill Pump & Well 0239 06/14/08
Print Name of Responsible Licensee and License No. Date

Michael McGill Sr.
Signature of Licensee

RECEIVED
JUL 02 2008
BY: OLWR

STATE WELL REPORT

Part 2

Pump Installer's Completion Report
Mississippi Department of Environmental Quality
Office of Land and Water Resources
P.O. Box 10631
Jackson, MS 39289-0631
(601)961-5210
(601)354-6938 (fax)

For Office Use Only:

Aquifer: _____

Well #: G-535

Elevation: _____

County: HARRISON
Permit #: 0239
Driller: McGill Pump & Well
Date completed: 06/12/08
Copy information from block on Part 1

This part of the report must be completed by a licensed water well contractor or a licensed pump installer. A copy of Part 1 of the report must be attached and both parts filed with the Department at the above address within 30 days of well completion.

Well Owner Information	Well Location
Owner Name: <u>Mr. Durandy</u>	Latitude: _____ Longitude: _____
Mailing Address: <u>16495 Mallard Dr.</u>	Method of Lat/Long (check one): Conventional Survey _____
<u>Gpt. MS. 39503</u>	USGS quad _____, Hand-held GPS _____, Survey-grade GPS _____
City State Zip Code	<u>1/4 1/4 Sec. 32 T 65 R 11 W</u>
Telephone No. <u>(228) 832-3654</u>	Distance Direction Nearest Town
	<u>11 Miles N of Gpt.</u>

Pump Type Circle one	Power Type Circle one
Air Lift <input type="checkbox"/>	Diesel Engine <input type="checkbox"/> Gasoline Engine <input type="checkbox"/> Natural Gas <input type="checkbox"/>
Bucket <input type="checkbox"/>	<input checked="" type="checkbox"/> Electric Motor <input type="checkbox"/> Hand <input type="checkbox"/> Tractor PTO <input type="checkbox"/>
Centrifugal <input type="checkbox"/>	Windmill <input type="checkbox"/> Other (specify): _____
Other (specify): _____	Horse Power Rating of Motor: <u>1 1/2</u>
Date Pump Installed: <u>06/12/08</u>	Setting Depth: <u>60</u> feet
Rated Pump Capacity: <u>24</u> Gallons Per Minute	Number of Stages: <u>8</u>

Pump Test Data	Method of Measuring Water Level Circle one
Date Well Tested: <u>06/12/08</u>	Air Line <input type="checkbox"/> Electric Measuring Line <input type="checkbox"/> <input checked="" type="checkbox"/> Steel Tape
Static Water Level (A): <u>30</u> Feet Below Land Surface	Other (specify): _____
Pumping Water Level (B): <u>60</u> Feet Below Land Surface	For flowing well, measured shut in head: _____ feet
Drawdown [(B) - (A)]: <u>40</u> Feet Below Land Surface	Well yielded <u>24</u> GPM with a drawdown of
Test Pumping Rate: <u>24</u> Gallons Per Minute	<u>40</u> feet after <u>4</u> hours of pumping
Duration of Pump Test (minimum 4 hours): <u>4</u> hours	

I HEREBY CERTIFY that the above statements are true to the best of my knowledge.

Michael McGill Sr. 0239
Print Name of Pump Installer and License No. (if applicable)

Michael McGill Sr.
Signature of Pump Installer

Form: OLWR-SWR-1B

RECEIVED
JUL 02 2008
BY: OLWR