

# State Well Report

## Part 1 - Driller's Log

Mississippi Department of Environmental Quality  
Office of Land and Water Resources  
P.O. Box 2309  
Jackson, MS 39225  
(601)961-5210  
(601)961-5228 (fax)

County: Harrison  
Permit #: MS-GW-16630  
Driller: Griner Drilling Service, Inc.  
Date drilling completed: 04/26/10

For Office Use Only:  
Aquifer: \_\_\_\_\_  
Well #: G-546  
L. S. Elevation: \_\_\_\_\_  
E-log #: \_\_\_\_\_

*State Law requires that this report be prepared by the license holder responsible for the work and filed with the Department at the above address within 30 days of completion of drilling of the well or borehole.*

Information on Well Owner (Landowner if borehole is not for a water well)	Well or Borehole Location
Owner Name: <u>Harrison County Utility Authority</u>	Latitude: <u>30°29'13.81"N</u> Longitude: <u>89° 3'3.17"W</u>
Mailing Address: <u>10271 Express Drive</u>	Method of Lat/Long (check one): Conventional Survey <input type="radio"/> <sup>14</sup> <sup>03</sup>
<u>Gulfport</u> <u>MS</u> <u>39503</u>	USGS quad <input type="radio"/> Hand-held GPS <input checked="" type="radio"/> Survey-grade GPS <input type="radio"/>
City State Zip Code	<u>SW 1/4 SW 1/4</u> Sec <u>25</u> Twn <u>6S</u> Rng <u>11W</u>
Telephone No. ( ) _____	Distance Direction Nearest Town <u>3.5</u> Miles <u>NE</u> of <u>Orange Grove</u>
	<u>Three Rivers Road well</u>

**Well / Borehole Data**

Date drilling started: 04/21/10 Date drilling completed: 04/26/10 Hole depth: 940 Hole diameter: 24"

Location of the source of any surface water used for drilling: \_\_\_\_\_  
Method of dosing and volume of Chlorine used in drilling and development: \_\_\_\_\_

Logs run (check all applicable): None  Electric  Gamma Ray  Density  Sonic  Neutron  Other: \_\_\_\_\_  
Name of organization running log(s): Griner Drilling Service, Inc.

Purpose of borehole (check one): Water Well  Geotechnical/Geological Investigation  Ground Source Heat Pump   
Seismic Survey  Other (describe) \_\_\_\_\_

*If drilling is not related to water well construction, skip the remainder of this block*

Purpose of Well (check one): Home  Industrial  Public Supply  Irrigation  Fish Culture  Other: \_\_\_\_\_

If a flowing well, method of flow regulation: Valve  Other (describe) \_\_\_\_\_

Static Water Level: 72' feet above  or below  land surface Date measured: 06/28/11

Method of Measurement (check one) steel tape  electric tape  air line  other: \_\_\_\_\_

Well depth: 768' Well grouted to a depth of 568 feet Type of grout (check one): Neat Cement  Bentonite  Mix

Casing length: 568 feet Casing diameter: 16 inches Type of casing: Steel

Screen length: 80 feet Screen diameter: 10 3/4 inches Type of screen: Stainless Steel

Screen slot size: .020 inches Setting depth: From 578 feet to 658 feet

Type of completion (check all applicable): Gravel packed  Underreamed  Telescoped  Open hole   
Natural Development  Other (describe): \_\_\_\_\_

Top of lap pipe or reduction in casing: 496 feet. *If telescoped or more than one screen, describe on next page*

Form: OLWR-SWR-1A (04/08)

RECEIVED

OCT 14 2011

BY: OLWR



# STATE WELL REPORT

## Part 2

**Pump Installer's Completion Report**  
 Mississippi Department of Environmental Quality  
 Office of Land and Water Resources  
 P.O. Box 2309  
 Jackson, MS 39225  
 (601)961-5210  
 (601)961-5228 (fax)

County: Harrison  
 Permit #: \_\_\_\_\_  
 Driller: Griner Drilling Service, Inc.  
 Date completed: 04/26/10  
Copy information from block on Part 1

**For Office Use Only:**

Aquifer: \_\_\_\_\_  
 Well #: 6546  
 Elevation: \_\_\_\_\_

*This part of the report must be completed by a licensed water well contractor or a licensed pump installer. A copy of Part 1 of the report must be attached and both parts filed with the Department at the above address within 30 days of well completion.*

Well Owner Information	Well Location
Owner Name: <u>Harrison County Utility Authority</u>	Latitude: <u>30°29'13.81"N</u> Longitude: <u>89° 3'3.17"W</u>
Mailing Address: <u>10271 Express Drive</u>	Method of Lat/Long (check one): Conventional Survey <input type="radio"/>
<u>Gulfport MS 39503</u>	USGS quad <input type="radio"/> Hand-held GPS <input checked="" type="radio"/> Survey-grade GPS <input type="radio"/>
City State Zip Code	<u>SW ¼ SW ¼ Sec 25 T 6S R 11W</u>
Telephone No. ( ) _____	Distance Direction Nearest Town <u>3.5</u> Miles <u>NE</u> of <u>Orange Grove</u>

Pump Type Check one	Power Type Check one
Air Lift <input type="radio"/> Jet <input type="radio"/> Submersible <input type="radio"/>	Diesel Engine <input type="radio"/> Gasoline Engine <input type="radio"/> Natural Gas <input type="radio"/>
Bucket <input type="radio"/> Piston <input type="radio"/> Turbine <input checked="" type="radio"/>	Electric Motor <input checked="" type="radio"/> Hand <input type="radio"/> Tractor PTO <input type="radio"/>
Centrifugal <input type="radio"/> Rotary <input type="radio"/> Flowing Well <input type="radio"/>	Windmill <input type="radio"/> Other (specify): _____
Other (specify): _____	Horse Power Rating of Motor: <u>125</u>
Date Pump Installed: <u>09/23/10</u>	Setting Depth: <u>202'</u> feet
Rated Pump Capacity: <u>1000</u> Gallons Per Minute	Number of Stages: <u>5</u>

Pump Test Data	Method of Measuring Water Level Check one
Date Well Tested: <u>06/28/10</u>	Air Line <input checked="" type="radio"/> Electric Measuring Line <input type="radio"/> Steel Tape <input type="radio"/>
Static Water Level (A): <u>72'</u> Feet Below Land Surface	Other (specify): _____
Pumping Water Level (B): <u>95.84</u> Feet Below Land Surface	For flowing well, measured shut in head: _____ feet
Drawdown [(B) - (A)]: <u>23.84</u> Feet Below Land Surface	Well yielded <u>1000</u> GPM with a drawdown of
Test Pumping Rate: <u>1000</u> Gallons Per Minute	<u>23.84</u> feet after <u>24</u> hours of pumping
Duration of Pump Test (minimum 4 hours): <u>24</u> hours	

This is for (check one):    New Well     Replacement of Existing Pump     Repair of Existing Pump


I HEREBY CERTIFY that the above statements are true to the best of my knowledge.

Charles H. Griner Sr.      0-184  
 Print Name of Pump Installer and License No. (if applicable)      Signature of Pump Installer

Form: OLWR-SWR-1G (07-09) 2011

RECEIVED  
 BY: OLWR

Harrison County Utility Authority W15  
Three Rivers Road  
Potable Water Well  
2010

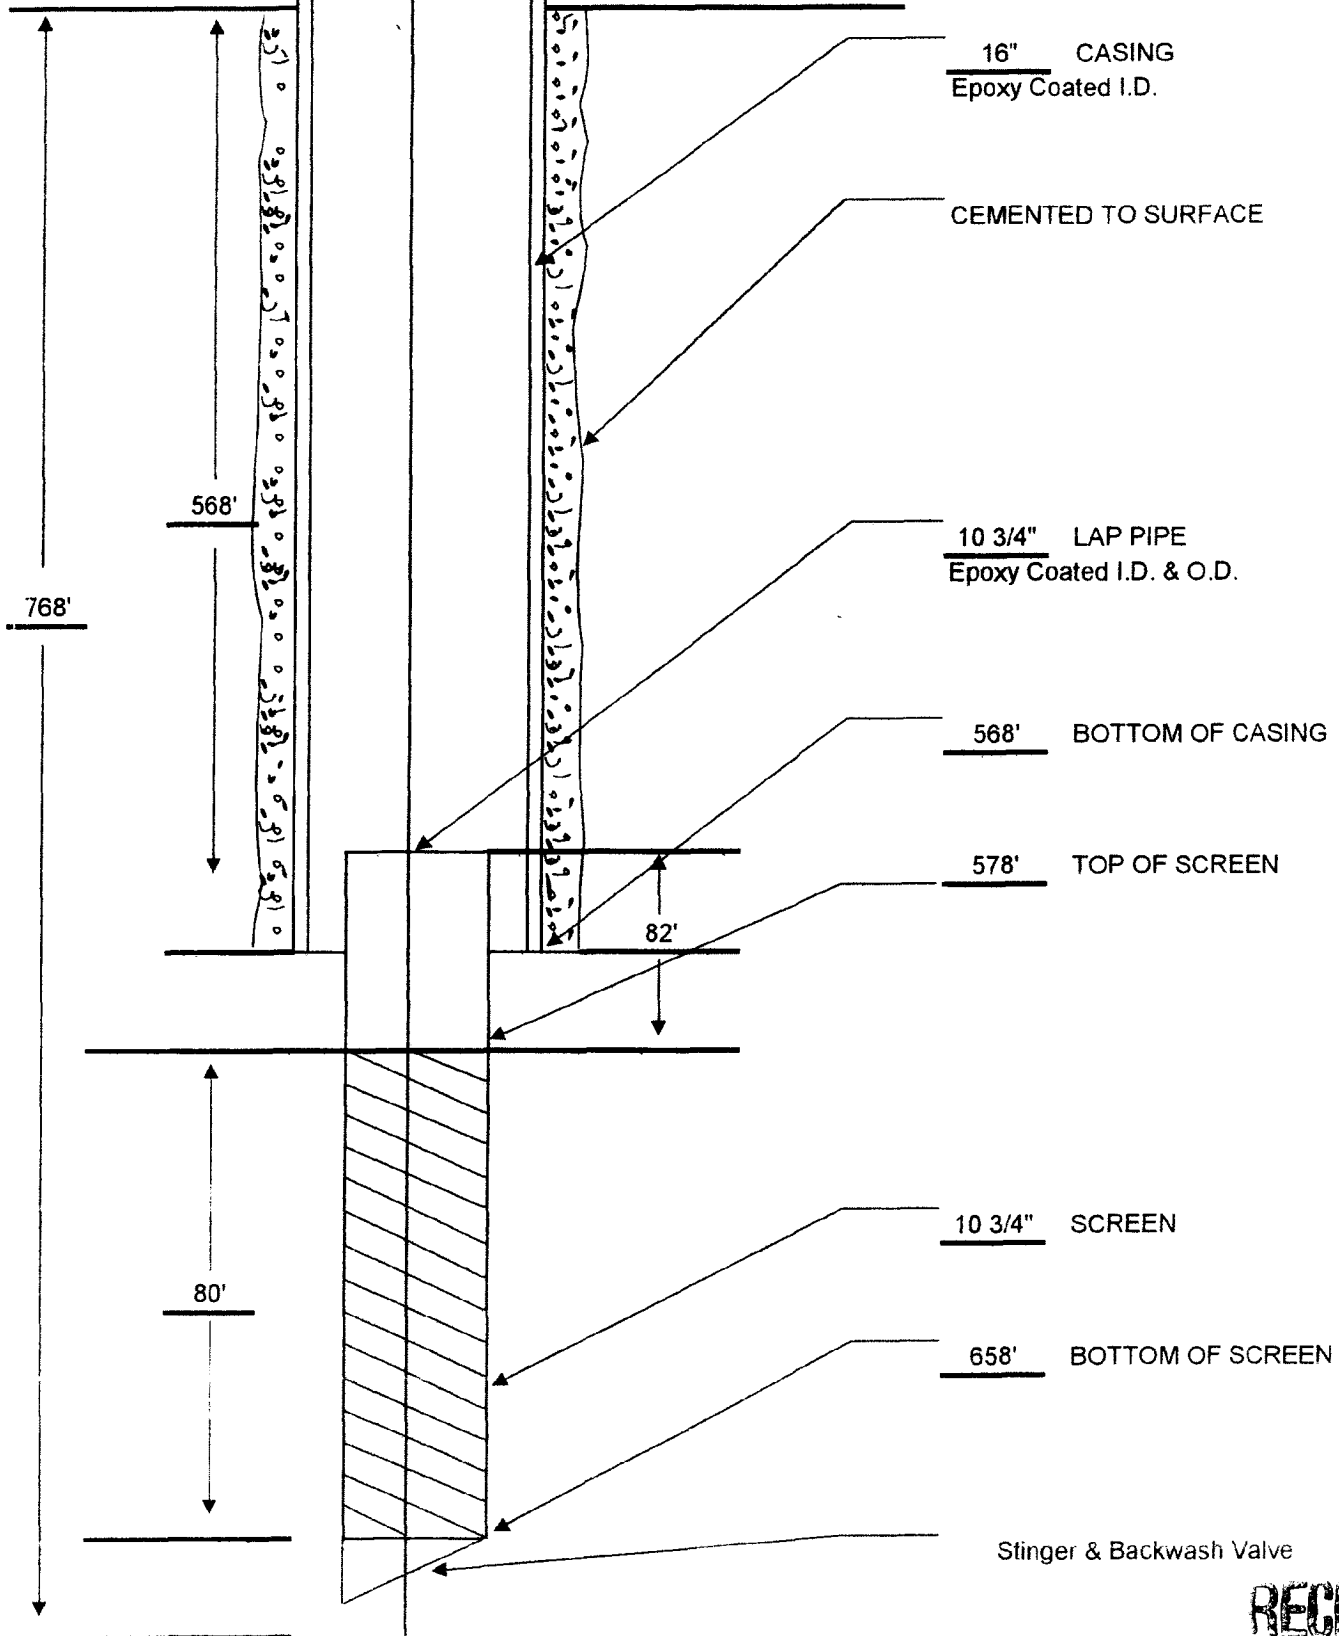

RECEIVED  
OCT 14 2011  
BY: OLWR