

State Well Report

Part 1

Mississippi Department of Environmental Quality
Office of Land and Water Resources
P.O. Box 10631
Jackson, MS 39289-0631
(601) 961-5210
(601) 354-6938 (fax)

For Office Use Only:

Aquifer: 6547
Well #: _____
L. S. Elevation: _____
E-log #: _____

County: HARRISON
Permit #: _____
Driller: Coast Water Well Serv
Date drilling completed: 6-27-12

State Law requires that this report be prepared by the driller in detail and filed with the Department within 30 days of completion of drilling of the well.

Well Owner Information	Well Location
Owner Name: <u>THOMAS DAVIS</u>	Latitude: <u>30° 29' 59.28"</u> Longitude: <u>089° 07' 55.50"</u>
Mailing Address: <u>14524 LUMPKIN ROAD</u>	Method of Lat/Long (circle one): Conventional Survey, USGS quad, <u>Hand-held GPS</u> , Survey-grade GPS <input checked="" type="checkbox"/>
<u>GULFPORT MS 39503</u> City State Zip Code	<u>SE 1/4 SW 1/4 Sec 19</u> Twn <u>T6S</u> Rng <u>R11W</u> NE NN 30 Distance Direction Nearest Town <u>5</u> Miles <u>NW</u> of <u>GULFPORT</u>
Telephone No. <u>(228) 832-5447</u>	

Well Data

Purpose of Well (circle one) Home Industrial Public Supply Irrigation Fish Culture Other: _____

Date well drilling started: 6-26-12 Date well drilling completed: 6-27-12

If flowing, method of flow regulation: Valve N/A Other (describe) _____

Static Water Level: 95 feet above or below (circle one) land surface Date measured: 6-27-12

Method of Measurement (circle one) steel tape electric tape air line other: _____

Hole depth: 497 Well depth: 497 Well grouted to a depth of 10 feet

Type of grout (circle one): Cement Bentonite Mix

Casing length: 482 feet Casing diameter: 2 inches Type of casing: PVC FH80

Screen length: 15 feet Screen diameter: 2 inches Type of screen: PVC Sch 80

Screen slot size: .006 inches Setting depth: From 482 feet to 497 feet

Type of completion (circle all applicable): Gravel packed Underreamed Telescoped Open hole Natural Development

Other (describe): _____

Top of lap pipe or reduction in casing: N/A feet. If telescoped or more than one screen, describe on back of page

Logs run (circle all applicable): No log run Electric Gamma Ray Density Sonic Neutron Other: _____

Name of organization running log(s): N/A

I certify that the well was drilled, constructed, and completed in accordance with all applicable requirements of the Mississippi Department of Environmental Quality and/or the Mississippi Department of Health regulations and state laws.

JACK RIDGDELL 0-472


Print Name of Water Well Contractor and License No.

Jack RidgdeLL
Signature of Water Well Contractor

5547

If well telescopes please sketch below and show depths.


Ground Level

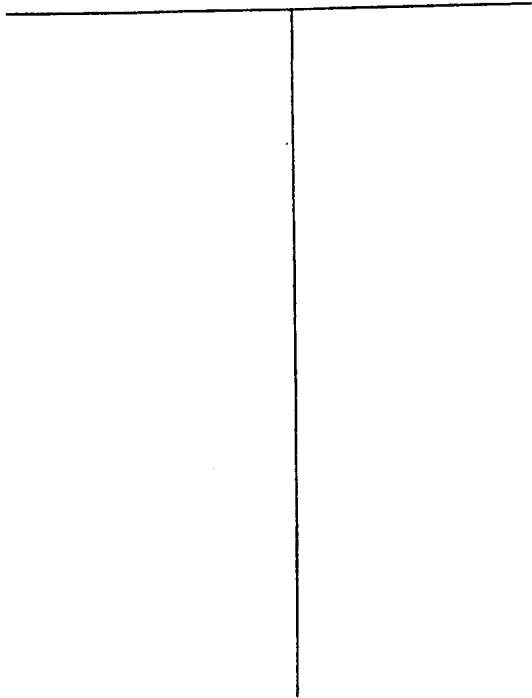

Description of Formations Encountered	From	To
Top Soil	0	2
Orange Clay	2	10
Blue Clay	10	13
Gray Coarse Sand	13	18
Blue Clay w/ streaks of sand	18	41
Gray Coarse Sand	41	49

If more than one screen, show location of each on sketch

Sketch the property layout and include the following: 1) the well location; 2) any permanent structures on the property that may aid in locating the well; 3) any roads, power lines, or other items that may aid in locating the property and the well; 4) indicate direction.

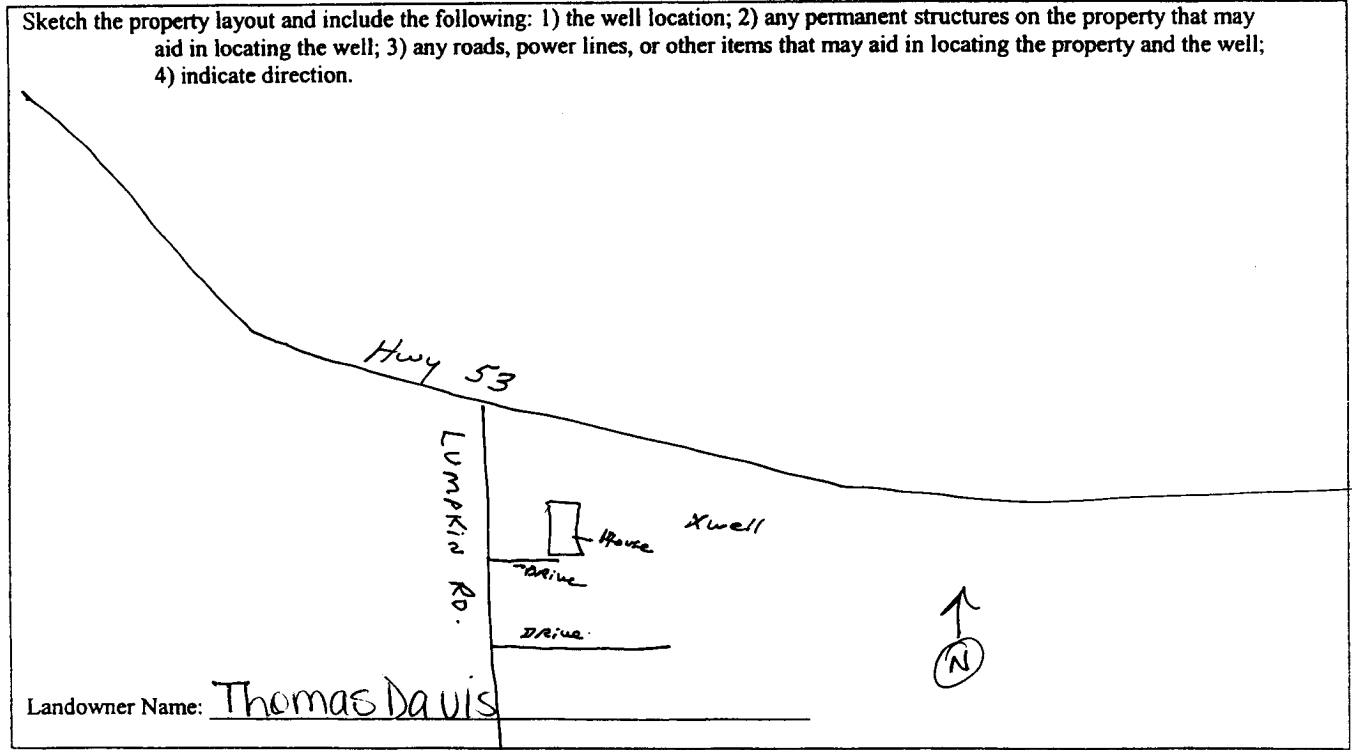

John Ritzler

 Signature of Water Well Contractor

RECEIVED
 JUL 25 2012

2547

STATE WELL REPORT

Part 2

Pump Installer's Completion Report
 Mississippi Department of Environmental Quality
 Office of Land and Water Resources
 P.O. Box 10631
 Jackson, MS 39289-0631
 (601) 961-5210
 (601) 354-6938 (fax)

County: HARRISON
 Permit #: _____
 Driller: COAST WATER WELL SERVICE
 Date completed: 6-28-12

For Office Use Only:
 Aquifer: _____
 Well #: 65A7
 Elevation: _____

This report should be prepared by the pump installer in detail and filed with the Department within 30 days of the installation of pump.

Well Owner Information	Well Location
Owner Name: <u>THOMAS DAVIS</u>	Latitude: <u>30°29'59.28"</u> Longitude: <u>089°07'55.50"</u>
Mailing Address: <u>14524 LUMPKIN RD</u>	Method of Lat/Long (circle one): Conventional Survey, USGS quad, <u>Hand-held GPS</u> , Survey-grade GPS
<u>Gulfport MS 39503</u> City State Zip Code	<u>SE 1/4 S4S 1/4 Sec 13 Twn T6S Rng R11 W</u> NE NW 30 Distance Direction Nearest Town
Telephone No. <u>(228) 832-5447</u>	<u>5 Miles NW of GULFPORT</u>

Pump Type Circle one	Power Type Circle one
Air Lift <input checked="" type="radio"/> Jet Submersible	Diesel Engine Gasoline Engine Natural Gas
Bucket <input type="radio"/> Piston Turbine	<input checked="" type="radio"/> Electric Motor Hand Tractor PTO
Centrifugal <input type="radio"/> Rotary Flowing Well	Windmill Other (specify): _____
Other (specify): _____	Horse Power Rating of Motor: <u>1</u>
Date Pump Installed: <u>6/20/12</u>	Setting Depth: <u>120 FT. DROP PIPE</u> feet
Rated Pump Capacity: <u>6</u> Gallons Per Minute	Number of Stages: <u>2</u>

Pump Test Data	Method of Measuring Water Level Circle one
Date Well Tested: <u>6/20/12</u>	Air <input checked="" type="radio"/> Line Electric Measuring Line Steel Tape
Static Water Level (A): <u>95</u> Feet Below Land Surface	Other (specify): _____
Pumping Water Level (B): <u>N/A</u> Feet Below Land Surface	For flowing well, measured shut in head: <u>N/A</u> feet
Drawdown [(B) - (A)]: <u>N/A</u> Feet Below Land Surface	Well yielded <u>22</u> GPM with a drawdown of
Test Pumping Rate: <u>6</u> Gallons Per Minute	<u>N/A</u> feet after <u>N/A</u> hours of pumping
Duration of Pump Test (minimum 4 hours): <u>4</u> hours	

I HEREBY CERTIFY that the above statements are true to the best of my knowledge.

JACK RIDGEBEL 0-472
 Print Name of Pump Installer and License No. (if applicable)

Jack Ridgabel
 Signature of Pump Installer