

MISSISSIPPI DEPARTMENT OF NATURAL RESOURCES

Bureau of Land and Water Resources

Southport Mall

P.O. Box 10631

Jackson, Mississippi 39209

WATER WELL DRILLERS LOG

Harrison  
G  
2000

3-7 1984  
 date well completed

McBee wells  
 firm name Inc.

Harrison  
 county well located

LANDOWNER: Mark-Vueky  
Smith Glenora Dr.  
Lynon Miss.  
 (mailing address)

description of formations encountered	from	to
	<u>med</u>	<u>0</u>
<u>med-sand</u>	<u>380</u>	<u>400</u>
<u>fine sand</u>	<u>400</u>	<u>420</u>
<u>coarse sand</u>	<u>420</u>	<u>440</u>

WELL LOCATION:  
 sec 30 T 6 N R 11 E  
3 miles N of Fuma  
 (distance) (direction) (nearest town)

WELL PURPOSE: Home  
 (home, irrigation, municipal, industrial)

- WELL COMPLETION DATA:
- (1) diameter (inches) 2"
  - (2) total depth (feet) 440'
  - (3) static water level (feet) 20' <sup>below</sup> top of ground.
  - (4) casing 50A. 40 PVC 430  
 (material) (depth)  
 (size) If telescope see back.
  - (5) screen 10' 430  
 (length) (depth to top)  
2" sch. 80 PVC  
 (size) (material)
  - (6) pump 1 HP. 9  
 (HP) (yield gpm)  
electric  
 (type power)
  - (7) electric log             
 (yes or no)  
 (organization running log)
  - (8) how well bottom plugged Good  
Thank

DEPT. OF NATURAL RESOURCES  
 BUREAU OF LAND & WATER RESOURCES


APR - 5 1984

RECEIVED

DRILLERS REMARKS:

If well telescopes please sketch and show depths.

GROUND LEVEL

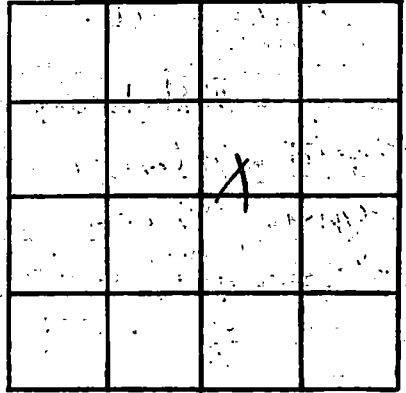

SECTION

30

Please indicate well location X.

ADDITIONAL INFORMATION

If more than one screen, show locations of each on sketch.