

MISSISSIPPI DEPARTMENT OF NATURAL RESOURCES
 Bureau of Land and Water Resources
 Southport Mall
 P.O. Box 10631
 Jackson, Mississippi 39209
WATER WELL DRILLERS LOG

Harrison
G
2001

3/15 1984 Braden Pump & Well Harrison
 date well completed firm name county well located

LANDOWNER: Mike Ervin
Rt. 5 Box 669
Gulfport MS
 (mailing address)

WELL LOCATION:
 sec. 36 T. 6 S. R. 11 W.
4 miles West of Woolmarket
 (distance) (direction) (nearest town)

WELL PURPOSE: Home
 (home, irrigation, municipal, industrial)

WELL COMPLETION DATA:
 (1) diameter (inches) 2"
 (2) total depth (feet) 500'
 (3) static water level (feet) 57 below above top of ground.
 (4) casing PVC, 580,
 (material) (depth)
 (size) if telescope see back.
 (5) screen 10, 480
 (length) (depth to top)
2",
 (size) (material)
 (6) pump 1 1/2, 5
 (HP) (yield gpm)
230V
 (type power)
 (7) electric log NO
 (yes or no)
 (organization running log)

(8) how well bottom plugged PVC
sandstone

DRILLERS REMARKS: 10'
tall pipe

description of formations encountered	from	to
Red Clay	0	20
Red Clay	20	40
Gray Clay	40	60
Yellow sand	60	80
White sand	80	100
Blue Clay	100	120
Clay	120	140
"	140	160
"	160	180
"	180	200
Sand & clay	200	220
Clay	220	240
Clay	240	260
Sand	260	280
Sand & Clay	280	300
clay	300	340
sand	340	500


DEPT. OF NATURAL RESOURCES
 BUREAU OF LAND & WATER RESOURCES

APR 18 1984

RECEIVED

If well telescopes please sketch and show depths.

GROUND LEVEL

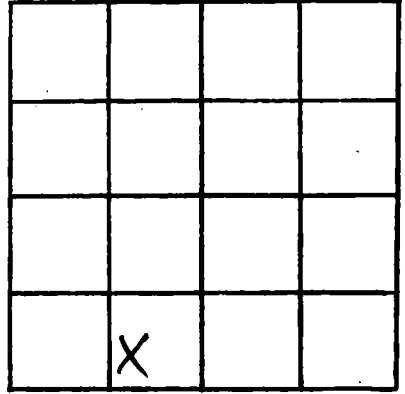

SECTION 36

Please indicate well location X.

ADDITIONAL INFORMATION

If more than one screen, show locations of each on sketch.