

MISSISSIPPI DEPARTMENT OF NATURAL RESOURCES

Bureau of Land and Water Resources

Southport Mall

P.O. Box 10631

Jackson, Mississippi 39209

WATER WELL DRILLERS LOG

Harrison
G
2002

date well completed 3-15 1984 firm name M'Hail Wells Inc. Harrison county well located _____

LANDOWNER: McHesse Homes
Hwy 49
apt. 202
 (mailing address)

description of formations encountered	from	to
<u>mucl</u>	<u>0</u>	<u>180</u>
<u>hard-mucl</u>	<u>180</u>	<u>220</u>
<u>mucl</u>	<u>220</u>	<u>280</u>
<u>mucl-hard</u>	<u>280</u>	<u>300</u>
<u>mucl</u>	<u>300</u>	<u>320</u>
<u>fine sand</u>	<u>320</u>	<u>340</u>
<u>clay sand</u>	<u>340</u>	<u>360</u>

WELL LOCATION:
 sec 30 T 6 N R 11 E
5 miles SE of Bzt
 (distance) (direction) (nearest town)

WELL PURPOSE: home
 (home, irrigation, municipal, industrial)

- WELL COMPLETION DATA:
- (1) diameter (inches) 2"
 - (2) total depth (feet) 360'
 - (3) static water level (feet) _____ below/above top of ground.
 - (4) casing Sch. 40 PVC 350'
 (material) (depth)
 - (size) If telescope see back.
 - (5) screen 10' 350'
 (length) (depth to top)
 - 2" Ach. 80
 (size) (material)
 - (6) pump 1 8
 (HP) (yield gpm)
 - Electric
 (type power)
 - (7) electric log _____
 (yes or no)
 - _____ (organization running log)
 - (8) how well bottom plugged Spud
Seal

DEPT. OF NATURAL RESOURCES
 BUREAU OF LAND & WATER RESOURCES


APR - 5 1984

RECEIVED

DRILLERS REMARKS: _____

If well telescopes please sketch and show depths.

GROUND LEVEL

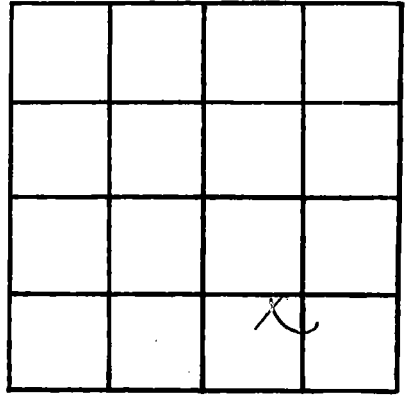

SECTION 30

Please indicate well location X.

ADDITIONAL INFORMATION

If more than one screen, show locations of each on sketch.