

MISSISSIPPI DEPARTMENT OF NATURAL RESOURCES

Bureau of Land and Water Resources

Southport Mall

P.O. Box 10631

Jackson, Mississippi 39209

WATER WELL DRILLERS LOG

COASTAL DRILLING & SERVICE CO.

Harrison  
 6-16-84  
 2005  
 6/16/84  
 date well completed

RT. 119 BOX 81

Harrison  
 county well located

LANDOWNER: Ray Meade

Highway 494 I D

Gulfport, MS  
 (mailing address)

WELL LOCATION:

sec. 11 T. 6 N. R. 11 E.  
 S W

(distance) miles (direction) of (nearest town)

WELL PURPOSE: home  
 (home, irrigation, municipal, industrial)

WELL COMPLETION DATA:

- (1) diameter (inches) 2"
- (2) total depth (feet) 250
- (3) static water level (feet) 10 below above top of ground.

(4) casing PVC, 240,  
 (material) (depth)  
 (size) If telescope see back.

(5) screen 10, 240  
 (length) (depth to top)  
2", PVC  
 (size) (material)

(6) pump 1, 17 1/2  
 (HP) (yield gpm)  
elo.  
 (type power)

(7) electric log NO  
 (yes or no)  
 (organization running log)

(8) how well bottom plugged 2" back wash valve 17-8

DRILLERS REMARKS:


description of formations encountered	from	to
top soil	1	3
red clay	3	20
sugar sand	20	45
soft blue clay	45	190
hard blue clay	190	230
fine water sand	230	250
good water sand	250	250

RECEIVED  
 JUL 22 1985

Department of Natural Resources  
 Bureau of Land & Water Resources

If well telescopes please sketch and show depths.

GROUND LEVEL

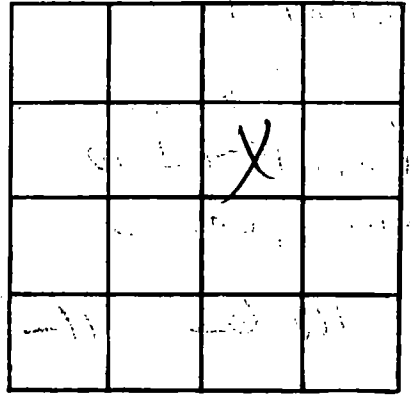

SECTION \_\_\_\_\_

Please indicate well location X.

**ADDITIONAL INFORMATION**

Lined area for additional information, containing faint handwritten notes.

If more than one screen, show locations of each on sketch.