

MISSISSIPPI DEPARTMENT OF NATURAL RESOURCES

Bureau of Land and Water Resources

Southport Mall

P.O. Box 10631

Jackson, Mississippi 39209

WATER WELL DRILLERS LOG  
COASTAL DRILLING & SERVICE CO.

Harrison  
~~E~~ G  
6-16-84  
2006

6/16/84  
date well completed

RI. 18 BOX 81

Harrison  
county well located

LANDOWNER: A. J. Edwards

BILOXI MS 39532

description of formations encountered

from to

Hindles Rd.

top soil

1 3

Gulfport, MS

red clay

3 20

(mailing address)

sugar sand

20 50

WELL LOCATION:

both blue clay

50 130

sec. 29 T. 6 N. R. 11 E  
S W

hard blue clay

130 230

Gulfport (distance) W (direction) of Harrison (nearest town)

fine water sand

230 240

WELL PURPOSE: home  
(home, irrigation, municipal, industrial)

good water sand

240 252

WELL COMPLETION DATA:

- (1) diameter (inches) 2"  
(2) total depth (feet) 250  
(3) static water level (feet) 10 below above top of ground.

- (4) casing PVC, 240,  
(material) (depth)  
2" if telescope see back.  
(size)

- (5) screen 10, 240  
(length) (depth to top)  
2", PVC  
(size) (material)

- (6) pump 1, 1812  
(HP) (yield gpm)  
clc.  
(type power)

- (7) electric log NO  
(yes or no)

(organization running log)

- (8) how well bottom plugged 2" back  
wash (10 lbs, 19-A)

DRILLERS REMARKS:


RECEIVED

JUL 22 1985

Department of Natural Resources  
Bureau of Land & Water Resources

If well telescopes please sketch and show depths.

GROUND LEVEL

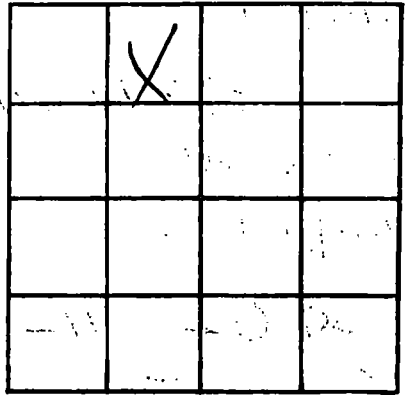

SECTION \_\_\_\_\_

Please indicate well location X.

ADDITIONAL INFORMATION

If more than one screen,  
show locations of each on sketch.