

Harrison
G
2009

MISSISSIPPI DEPARTMENT OF NATURAL RESOURCES
 Bureau of Land and Water Resources
 Southport Mall
 P.O. Box 10631
 Jackson, Mississippi 39209
WATER WELL DRILLERS LOG

11/7/84 19 1984 Lyman Well Co. Harrison
 date well completed firm name county well located

LANDOWNER: Robert C. Evans, Jr.
Rt. 3, Box 600A
Gulfport, MS 39503
 (mailing address)

WELL LOCATION:
 sec 24 T 6 N R 11 E
12 miles N of Gpt.
 (distance) (direction) (nearest town)

WELL PURPOSE: Home
 (home, irrigation, municipal, industrial)

WELL COMPLETION DATA:

- (1) diameter (inches) 2
- (2) total depth (feet) 473
- (3) static water level (feet) 90 below above
 top of ground.
- (4) casing PVC 463'
 (material) (depth)
2" If telescope see back.
 (size)
- (5) screen 10' 463'
 (length) (depth to top)
2" PVC
 (size) (material)
- (6) pump 1 1/2 10
 (HP) (yield gpm)
electric
 (type power)
- (7) electric log NO
 (yes or no)
NO
 (organization running log)
- (8) how well bottom plugged sand
shark

description of formations encountered	from	to
<u>yellow mud</u>	<u>0</u>	<u>20</u>
<u>blue mud</u>	<u>20</u>	<u>80</u>
<u>white sand</u>	<u>80</u>	<u>120</u>
<u>blue mud</u>	<u>120</u>	<u>200</u>
<u>fine blue sand</u>	<u>200</u>	<u>240</u>
<u>blue mud</u>	<u>240</u>	<u>320</u>
<u>blue fine sand</u>	<u>320</u>	<u>360</u>
<u>blue mud</u>	<u>360</u>	<u>420</u>
<u>coarse sand</u>	<u>420</u>	<u>473</u>

DRILLERS REMARKS:


DEPT. OF NATURAL RESOURCES
 BUREAU OF LAND & WATER RESOURCES

DEC 17 1984

RECEIVED

If well telescopes please sketch and show depths.

GROUND LEVEL

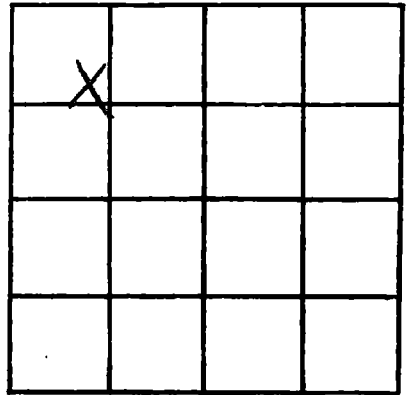

SECTION 34

Please indicate well location X.

ADDITIONAL INFORMATION

If more than one screen,
show locations of each on sketch.