

MISSISSIPPI DEPARTMENT OF NATURAL RESOURCES

Bureau of Land and Water Resources

Southport Mall

P.O. Box 106314

Jackson, Mississippi 39209

WATER WELL DRILLERS LOG

Harrison
G
2010

11/20/84
 date well completed

19

Lyman Well Co.
 firm name

Harrison
 county well located

LANDOWNER:

Bobby Page

description of formations encountered

from

to

South Swan Rd.
Southport, MS 39503
 (mailing address)

<u>yellow mud.</u>	<u>0</u>	<u>80</u>
<u>fine sand.</u>	<u>81</u>	<u>120</u>
<u>blue mud.</u>	<u>121</u>	<u>420</u>
<u>sandy blue mud.</u>	<u>421</u>	<u>440</u>
<u>sand</u>	<u>441</u>	<u>473</u>

WELL LOCATION:

sec. 28 T. 6 N. R. 11 E.
8 miles NE of Gpt
 (distance) (direction) (nearest town)

WELL PURPOSE:

Home
 (home, irrigation, municipal, industrial)

WELL COMPLETION DATA:

- (1) diameter (inches) 2
- (2) total depth (feet) 473
- (3) static water level (feet) 65 ^{below} _{above} top of ground.
- (4) casing PVC, 463'
 (material) (depth)
2" if telescope see back.
 (size)
- (5) screen 10', 463'
 (length) (depth to top)
2", PVC
 (size) (material)
- (6) pump 1 1/2, 14
 (HP) (yield gpm)
electric
 (type power)
- (7) electric log No
 (yes or no)
No
 (organization running log)
- (8) how well bottom plugged sand
Shark


DEPT. OF NATURAL RESOURCES
 BUREAU OF LAND & WATER RESOURCES

DEC 17 1984
RECEIVED

DRILLERS REMARKS:

If well telescopes please sketch and show depths.

GROUND LEVEL

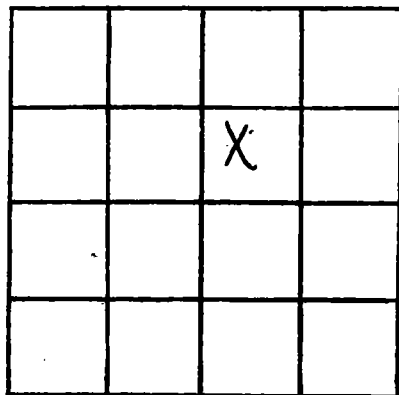

SECTION 28

Please indicate well location X.

ADDITIONAL INFORMATION

If more than one screen, show locations of each on sketch.