

MISSISSIPPI DEPARTMENT OF NATURAL RESOURCES

Bureau of Land and Water Resources

Southport Mall

P.O. Box 10631

Jackson, Mississippi 39209

WATER WELL DRILLERS LOG
COASTAL DRILLING & SERVICE CO.

ROUTE 1 BOX 618

HARRISON
county well located

BILOXI, MISS. 39532

Harrison
G 2013
6-6-84

6/6/84

date well completed

LANDOWNER: L.A. BLACKWELL

Gulfport, Miss

(mailing address)

WELL LOCATION:

sec. 33 T. 6-N R. 11-E S W

Gulfport

(distance) (direction) (nearest town)

WELL PURPOSE: HOME
(home, irrigation, municipal, industrial)

WELL COMPLETION DATA:

- (1) diameter (inches) 2'
- (2) total depth (feet) 90
- (3) static water level (feet) 20 below above top of ground.
- (4) casing PVC 80 (material) (depth)
- (size) If telescope see back.
- (5) screen 10' 80 (length) (depth to top)
- 2' (size) PVC (material)
- (6) pump 1 (HP) 28 11 (yield gpm)
- Etc. (type power)
- (7) electric log NO (yes or no)

(organization running log)

(8) how well bottom plugged 2' back-WASH VALVE 19-B

description of formations encountered

from to

top soil	1	3
red clay	3	20
soft blue clay	20	35
fine water sand	35	75
fine sand shell	75	80
good water sand	80	90

DRILLERS REMARKS:


RECEIVED

JUL 22 1985

Department of Natural Resources
Bureau of Land & Water Resources

If well telescopes please sketch and show depths.

GROUND LEVEL

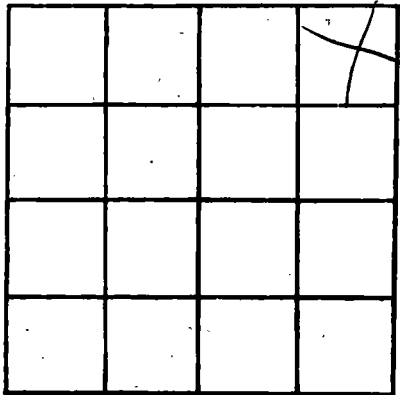

SECTION _____

Please indicate well location X.

ADDITIONAL INFORMATION

If more than one screen, show locations of each on sketch.