

MISSISSIPPI DEPARTMENT OF NATURAL RESOURCES

Bureau of Land and Water Resources

Southport Mall

P.O. Box 10631

Jackson, Mississippi 39209

WATER WELL DRILLERS LOG

COASTAL DRILLING & SERVICE CO.

Harrison  
G 2014  
7-10-84

7/10/84  
date well completed

ROUTE 1 BOX 018  
home

HARRISON  
county well located

BILOXI, MISS. 39532

LANDOWNER: Greenlee Smith

description of formations encountered

from to

Rt. 1 BOX 385

top soil

1 3

Saucier, MS

red clay

3 20

(mailing address)

SUGAR SAND

20 30

WELL LOCATION:

sec. 24 T. 4-N R. 11-E  
S S W

soft blue clay

30 140

Saucier

(distance) (direction) (nearest town)

fine water sand

140 160

WELL PURPOSE: home

(home, irrigation, municipal, industrial)

good water sand

160 170

WELL COMPLETION DATA:

- (1) diameter (inches) 2'
- (2) total depth (feet) 170
- (3) static water level (feet) 10 below above top of ground.

- (4) casing PVC, 160  
(material) (depth)

(size) if telescope see back.

- (5) screen 10, 160  
(length) (depth to top)

2', PVC  
(size) (material)

- (6) pump 1, 28-10  
(HP) (yield gpm)

etc.  
(type power)

- (7) electric log NO  
(yes or no)

(organization running log)

- (8) how well bottom plugged 2' back  
WASH WAVE 19-B

DRILLERS REMARKS:


RECEIVED

JUL 22 1985

Department of Natural Resources  
Bureau of Land & Water Resources

If well telescopes please sketch and show depths.

GROUND LEVEL

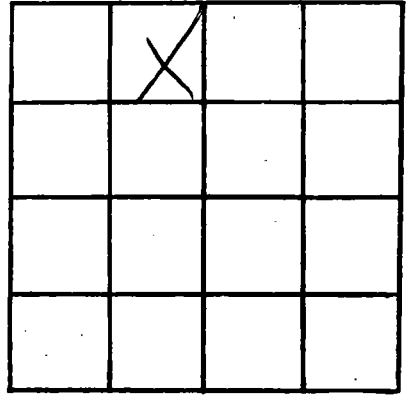

SECTION \_\_\_\_\_

Please indicate well location X.

ADDITIONAL INFORMATION

If more than one screen, show locations of each on sketch.