

MISSISSIPPI DEPARTMENT OF NATURAL RESOURCES

Bureau of Land and Water Resources

Southport Mall

P.O. Box 10631

Jackson, Mississippi 39209

WATER WELL DRILLERS LOG

Harrison
G 2015
6-15-84

6/15/84
date well completed

RT. 11, BOX 81

Harrison
county well located

BILOXI, MS 39532

LANDOWNER: Ray Davis
Orange Grove Rd.
Gulfport, MS
(mailing address)

WELL LOCATION:
sec. 32 T. 6 N. R. 11 E
S W
Gulfport
(distance) (direction) (nearest town)

WELL PURPOSE: home
(home, irrigation, municipal, industrial)

WELL COMPLETION DATA:

(1) diameter (inches) 4" x 2"
(2) total depth (feet) 600
(3) static water level (feet) 10 ~~50~~ below
top of ground.
(4) casing PVC, 585'
(material) (depth)
4" x 2" if telescope see back.
(size)
(5) screen 15', 585'
(length) (depth to top)
2", PVC
(size) (material)
(6) pump 1 1/2, 20
(HP) (yield gpm)
E/C
(type power)
(7) electric log NO
(yes or no)
(organization running log)
(8) how well bottom plugged 2" back
wash valve, 19-B

description of formations encountered	from to	
	feet	feet
top soil	1	3
red clay	3	20
sugar sand	20	50
course white sand	50	710
soft blue clay	110	330
hard blue clay	330	470
course white sand	470	480
blue clay	480	580
fine water sand	580	590
good water sand	590	600

RECEIVED

JUL 22 1985

DRILLERS REMARKS:

Department of Natural Resources
Bureau of Land & Water Resources

If well telescopes please sketch and show depths.


GROUND LEVEL

160' 4" pvc casing

440' 2" pvc casing

15' 2" pvc screen

2" back wash valve

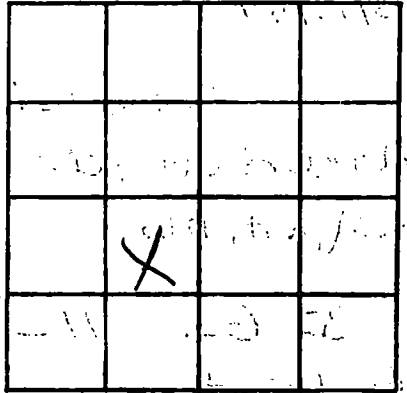

SECTION _____

Please indicate well location X.

ADDITIONAL INFORMATION

If more than one screen, show locations of each on sketch.