

MISSISSIPPI DEPARTMENT OF NATURAL RESOURCES

Bureau of Land and Water Resources

Southport Mall

P.O. Box 10631

Jackson, Mississippi 39209

WATER WELL DRILLERS LOG

and Drilling & Service Co.

Harrison  
6 2016  
6-15-84

L

6/15/84 19 81 11 BOX 81 Harrison  
 date well completed firm name county well located

Blount, MS 39532

LANDOWNER: Phillip Brothers  
Robertson Rd.  
Gulfport, MS  
 (mailing address)

description of formations encountered	from	to
top soil	1	5
red clay	5	25
sugar sand	25	55
soft blue clay	55	140
course white sand	140	260
hard blue clay	260	380
sugar sand	380	390
blee clay	390	470
fine water sand	470	480
good water sand	480	490

WELL LOCATION:  
 sec 31 T 6 N R 11 E  
S W  
Gulfport of \_\_\_\_\_  
 (distance) (direction) (nearest town)

WELL PURPOSE: HOME  
 (home, irrigation, municipal, industrial)

WELL COMPLETION DATA:

(1) diameter (inches) 2"

(2) total depth (feet) 490

(3) static water level (feet) 10 below/above top of ground.

(4) casing PVC, 480,  
 (material) (depth)

(size) If telescope see back.

(5) screen 10', 480'  
 (length) (depth to top)

2', PVC  
 (size) (material)

(6) pump 1, 18  
 (HP) (yield gpm)

etc.  
 (type power)

(7) electric log NO  
 (yes or no)

(organization running log)

(8) how well bottom plugged 2" back  
was drilled 19-B

**RECEIVED**


JUL 22 1985

DRILLERS REMARKS: \_\_\_\_\_

Department of Natural Resources  
 Bureau of Land & Water Resources

If well telescopes please sketch and show depths.

GROUND LEVEL

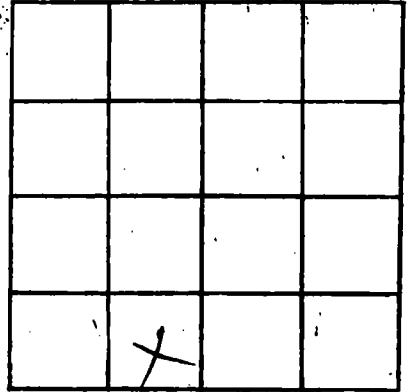

SECTION \_\_\_\_\_

Please indicate well location X.

ADDITIONAL INFORMATION

A series of horizontal lines for writing additional information.

If more than one screen, show locations of each on sketch.