

MISSISSIPPI DEPARTMENT OF NATURAL RESOURCES

Bureau of Land and Water Resources

Southport Mall

P.O. Box 10631

Jackson, Mississippi 39209

WATER WELL DRILLERS LOG
COASTAL DRILLING & SERVICE CO.

Harrison
 G 2017
 6-15-84

L

6/15/84 19
 date well completed

RT. 11, BOX 81
 Hill Point

Harrison
 county well located

DIXON, MS 39532

LANDOWNER: Cindy Walker

description of formations encountered

from to

Dairy Hill Farm
Murphy, MS
 (mailing address)

description of formations encountered	from	to
top soil	1	5
sugar sand	5	25
red clay	25	120
soft blue clay	120	245
hard blue clay	245	360
coarse white sand	360	390
hard blue clay	390	530
fine water sand	530	540
good water sand	540	550

WELL LOCATION:

sec. 25 T. 6 N. R. 10 E.
 S W
Murphy of
 (distance) (direction) (nearest town)

WELL PURPOSE: HOME
 (home, irrigation, municipal, industrial)

WELL COMPLETION DATA:

- (1) diameter (Inches) 2"
- (2) total depth (feet) 350
- (3) static water level (feet) 10 below top of ground.
- (4) casing PVC, 540
 (material) (depth)
 (size) If telescope see back.
- (5) screen 10", 540
 (length) (depth to top)
2", PVC
 (size) (material)
- (6) pump 1, 79
 (HP) (yield gpm)
clc.
 (type power)
- (7) electric log NO
 (yes or no)

(organization running log)
 (8) how well bottom plugged 2' back wash 10/26/84


DRILLERS REMARKS:

RECEIVED
 JUL 22 1985

Department of Natural Resources
 Bureau of Land & Water Resources

If well telescopes please sketch and show depths.

GROUND LEVEL

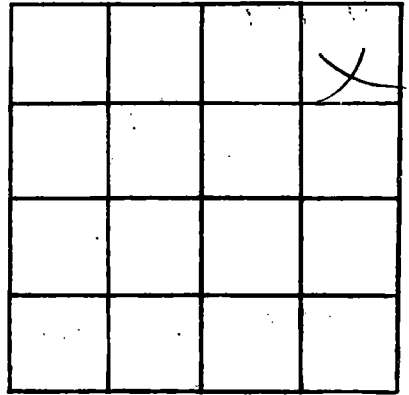

SECTION _____

Please indicate well location X.

ADDITIONAL INFORMATION

If more than one screen,
show locations of each on sketch.