

MISSISSIPPI DEPARTMENT OF NATURAL RESOURCES

Bureau of Land and Water Resources

Southport Mall

P.O. Box 10631

Jackson, Mississippi 39209

WATER WELL DRILLERS LOG

RT. 11, BOX 81

Harrison

BILOXI, MS 39532

county well located

HARRISON
G 2018

6/20/84

date well completed

19

LANDOWNER: Inoy Chapman

description of formations encountered

from

to

1250 Ramsey Rd

top soil

1 10

Saucier, MS
(mailing address)

silica sand

10 30

WELL LOCATION:

sec 25 T 6 N R 11 E
S W

red clay

30 150

Saucier miles of _____
(distance) (direction) of (nearest town)

coarse white sand

150 180

WELL PURPOSE: NONE
(home, irrigation, municipal, industrial)

soft blue clay

180 290

WELL COMPLETION DATA:

- (1) diameter (inches) 2"
- (2) total depth (feet) 600
- (3) static water level (feet) 590 below top of ground.

coarse white sand

290 320

- (4) casing PVC, 590
(material) (depth)

hard blue clay

320 450

(size) If telescope see back.

- (5) screen 10, 590
(length) (depth to top)

red clay

450 580

2", PVC
(size) (material)

- (6) pump 1 1/2, 23
(HP) (yield gpm)

fine water sand

580 590

Etc.
(type power)

- (7) electric log NO
(yes or no)

top water sand

590 600

(organization running log)

- (8) how well bottom plugged 2" back
washed 1983

RECEIVED


AUG - 5 1985

Department of Natural Resources
Bureau of Land & Water Resources

DRILLERS REMARKS:

If well telescopes please sketch and show depths.

GROUND LEVEL

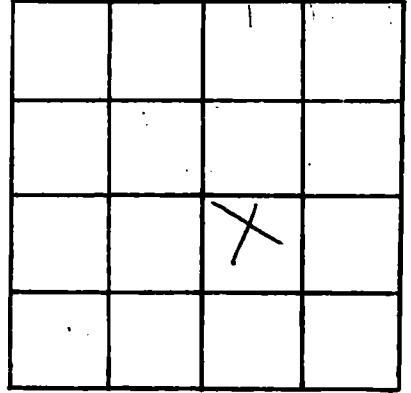

SECTION _____

Please indicate well location X.

ADDITIONAL INFORMATION

If more than one screen, show locations of each on sketch.