

MISSISSIPPI DEPARTMENT OF NATURAL RESOURCES

Bureau of Land and Water Resources

Southport Mall

P.O. Box 10631

Jackson, Mississippi 39209

WATER WELL DRILLERS LOG

COASTAL DRILLING & SERVICE CO.

Harrison

Harrison  
G 2020  
7-30-84

7/30/84  
19 date well completed

ROUTE 1 BOX 618

county well located

LANDOWNER: Outs Lopoese Jr.

mill rd

Gulfport, MS  
(mailing address)

WELL LOCATION:

sec. 28 T. 1 N. R. 11 E. S. 5 W.  
Gulfport of Harrison  
(distance) (direction) (nearest town)

WELL PURPOSE: home  
(home, irrigation, municipal, industrial)

WELL COMPLETION DATA:

- (1) diameter (inches) 2"
- (2) total depth (feet) 320
- (3) static water level (feet) 10 below top of ground.
- (4) casing pvc, 310,  
(material) (depth)  
(size) If telescope see back.
- (5) screen 10, 310  
(length) (depth to top)  
2", pvc  
(size) (material)
- (6) pump 1, 79  
(HP) (yield gpm)  
etc.  
(type power)
- (7) electric log NO  
(yes or no)  
(organization running log)
- (8) how well bottom plugged 2" pack  
WASH VALVE 19-B

MISS. 39532  
description of formations encountered

	from	to
top soil	1	3
red clay	3	20
sugar sand	20	40
coarse white sand	40	80
hard blue clay	80	160
soft blue clay	160	280
fine water sand	280	310
good water sand	310	320


RECEIVED  
JUL 22 1985

Department of Natural Resources  
Bureau of Land & Water Resources

DRILLERS REMARKS:

If well telescopes please  
sketch and show depths.

GROUND LEVEL

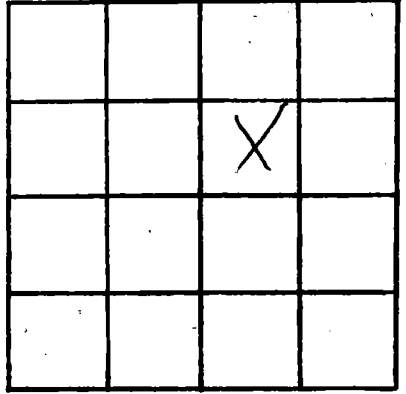

SECTION \_\_\_\_\_

Please indicate well location X.

**ADDITIONAL INFORMATION**

If more than one screen,  
show locations of each on sketch.