

MISSISSIPPI DEPARTMENT OF NATURAL RESOURCES

Bureau of Land and Water Resources

Southport Mall

P.O. Box 10631

Jackson, Mississippi 39209

WATER WELL DRILLERS LOG

COASTAL DRILLING & SERVICE CO.

Harrison
 G 2024
 8-8-84

8/8/84

date well completed

RT. 2 BOX 01

harrison county well located

LANDOWNER: Mrs. Hill

Baptist church

Rt. 2 BOX 185

BILBO

description of formations encountered

from

to

topsoil	1	3
red clay	3	20
sugar band	20	30
soft blue clay	50	180
hard blue clay	180	240
course white sand	240	250
hard blue clay	250	315
blue water sand	315	325
good water band	325	335

Saucin, MS

(mailing address)

WELL LOCATION:

sec. 25 T. 16 N. R. 11 E
 S W

Saucin miles

(distance) (direction) (nearest town)

WELL PURPOSE: Municipal
 (home, irrigation, municipal, industrial)

WELL COMPLETION DATA:

- (1) diameter (inches) 2"
- (2) total depth (feet) 335
- (3) static water level (feet) 10 below above top of ground.
- (4) casing PVC, 325,
 (material) (depth)

(size) If telescope see back.

- (5) screen 10', 325
 (length) (depth to top)
- 2", PVC
 (size) (material)
- (6) pump 2, 30-20
 (HP) (yield gpm)
- etc.
 (type power)

(7) electric log 1110
 (yes or no)

(organization running log)

(8) how well bottom plugged 2" back wash well. 19-8

DRILLERS REMARKS: none


RECEIVED

JUL 22 1985

Department of Natural Resources
 Bureau of Land & Water Resources

If well telescopes please sketch and show depths.

GROUND LEVEL

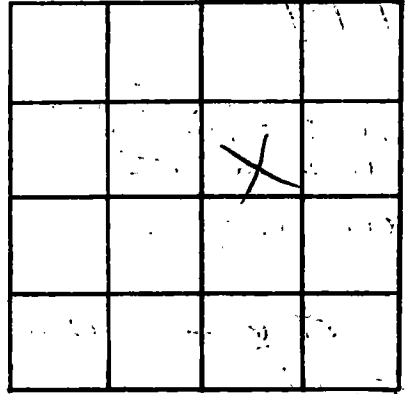

SECTION _____

Please indicate well location X.

ADDITIONAL INFORMATION

If more than one screen, show locations of each on sketch.