

MISSISSIPPI DEPARTMENT OF NATURAL RESOURCES

Bureau of Land and Water Resources

Southport Mall

P.O. Box 10631

Jackson, Mississippi 39209

WATER WELL DRILLERS LOG

COASTAL DRILLING & SERVICE CO.

Harrison
G 2026
2-9-85

2/9/85 19 RT. 11, BOX 81 Harrison
date well completed film name county well located

PHOXI, MS 39532

LANDOWNER: Ken Jordan

Hwy 49
Mulletport, MS
(mailing address)

WELL LOCATION:

sec. 33 T. 6-N R. 11-E
S W

Mulletport of
(distance) (direction) of (nearest town)

WELL PURPOSE: home
(home, irrigation, municipal, industrial)

WELL COMPLETION DATA:

(1) diameter (inches) 2"
(2) total depth (feet) 460
(3) static water level (feet) 10 below
top of ground. above

(4) casing PVC, 450,
(material) (depth)

(size) If telescope see back.

(5) screen 10' 450
(length) (depth to top)

2" PVC
(size) (material)

(6) pump 1 9
(HP) (yield gpm)

EC
(type power)

(7) electric log 40
(yes or no)

(organization running log)

(8) how well bottom plugged 2" back
washalux

DRILLERS REMARKS: 19-B


description of formations encountered	from	to
top soil	1	10
sugar sand	10	30
red clay	30	180
soft blue clay	180	310
hard blue clay	310	440
fine water sand	440	450
good water sand	450	460

RECEIVED
JUL 25 1985

Department of Natural Resources
Bureau of Land & Water Resources

If well telescopes please sketch and show depths.

GROUND LEVEL

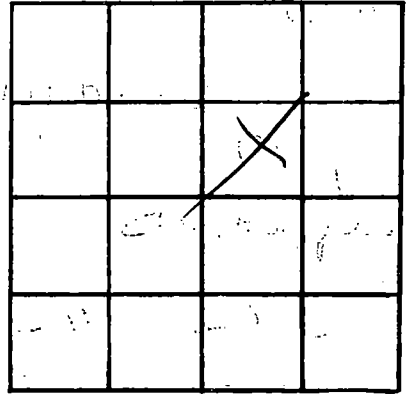

SECTION _____

Please indicate well location X.

ADDITIONAL INFORMATION

If more than one screen,
show locations of each on sketch.