




If well telescopes please sketch and show depths.

GROUND LEVEL

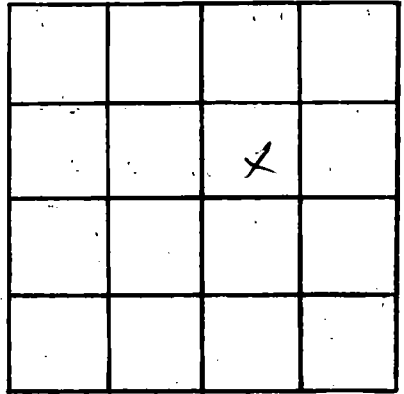

SECTION 27

Please indicate well location X.

**ADDITIONAL INFORMATION**

If more than one screen,  
show locations of each on sketch.