

MISSISSIPPI DEPARTMENT OF NATURAL RESOURCES

Bureau of Land and Water Resources

Southport Mall

P.O. Box 10631

Jackson, Mississippi 39209

WATER WELL DRILLERS LOG  
 COASTAL DRILLING & SERVICE CO.

Harrison  
 G 2031  
 6-15-84

6/15/84 19 RT. 11 BOX 81 6/15/84  
 date well completed firm name county well located

LANDOWNER: DAVID CHAPMAN  
Planty Down Road  
Saucier, MS  
 (mailing address)

WELL LOCATION:  
 sec. 29 T. 6 N. R. 11 E  
 S W  
Saucier miles of  
 (distance) (direction) (nearest town)

WELL PURPOSE: home  
 (home, irrigation, municipal, industrial)

WELL COMPLETION DATA:

(1) diameter (inches) 2"

(2) total depth (feet) 350

(3) static water level (feet) 10 below  
 top of ground.

(4) casing PVC, 340,  
 (material) (depth)  
 (size) If telescope see back.

(5) screen 10, 340  
 (length) (depth to top)  
2", PVC  
 (size) (material)

(6) pump 1 8  
 (HP) (yield gpm)  
Etc.  
 (type power)

(7) electric log NO  
 (yes or no)  
 (organization running log)

(8) how well bottom plugged 2" back  
wash valve

description of formations encountered	from	to
top soil	1	3
selgas sand	3	20
red clay	20	140
fine water sand	140	170
thick blue clay	170	330
fine water sand	330	340
good water sand	340	350

RECEIVED


JUL 25 1985

DRILLERS REMARKS: 19-3

Department of Natural Resources  
 Bureau of Land & Water Resources

If well telescopes please sketch and show depths.

GROUND LEVEL

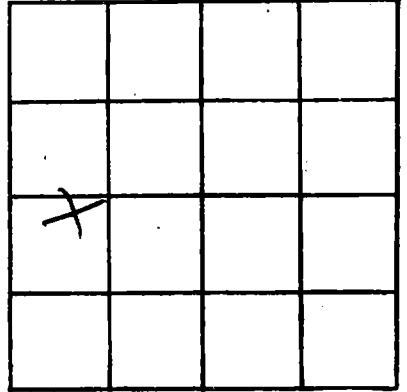

SECTION \_\_\_\_\_

Please indicate well location X.

ADDITIONAL INFORMATION

If more than one screen, show locations of each on sketch.