

MISSISSIPPI DEPARTMENT OF NATURAL RESOURCES

Bureau of Land and Water Resources

Southport Mall

P.O. Box 10631

Jackson, Mississippi 39209

WATER WELL DRILLERS LOG

Harrison  
G  
2032

12-3-85

M<sup>c</sup>Gill Pump & Wells

Harrison

date well completed

firm name

county well located

LANDOWNER: Jerry Lamley  
Robbinson Rd.

Gupt. Ms. 39503  
(mailing address)

WELL LOCATION:

sec 6 T 6 N R 11 E  
S  
5 miles N/W of Gupt  
(distance) (direction) (nearest town)

WELL PURPOSE: Home  
(home, irrigation, municipal, industrial)

WELL COMPLETION DATA: 4" = 200  
2" = 480

- (1) diameter (inches) 1 1/2
- (2) total depth (feet) 680
- (3) static water level (feet) 160 <sup>below</sup> top of ground.
- (4) casing Galv; 160'  
(material) (depth)

       (size) if telescope see back.

- (5) screen 20 160'  
(length) (depth to top)
- 2" stainless  
(size) (material)

- (6) pump 5 25  
(HP) (yield gpm)
- elec  
(type power)

- (7) electric log         
(yes or no)

        
(organization running log)

- (8) how well bottom plugged Seal

description of formations encountered

from

to

mud	0	20
mud	20	80
muds sand	80	140
sand & sand	140	160
mud & sand	160	180
mud	180	360
mud & sand	360	380
sand	380	400
mud	400	480
mud & sand	480	500
sand	500	560
sand & mud	560	580
mud	580	600
mud & sand	600	620
sand	620	680

**RECEIVED**


DEC 13 1985

Department of Natural Resources  
Bureau of Land & Water Resources

DRILLERS REMARKS:

If well telescopes please sketch and show depths.

GROUND LEVEL

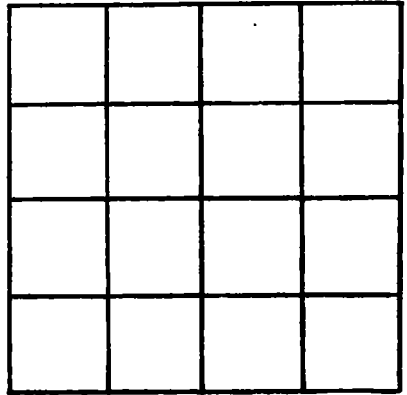

SECTION \_\_\_\_\_

Please indicate well location X.

ADDITIONAL INFORMATION

If more than one screen, show locations of each on sketch.