

MISSISSIPPI DEPARTMENT OF NATURAL RESOURCES
Bureau of Land and Water Resources
 Southport Mall
 P.O. Box 10631
 Jackson, Mississippi 39209
WATER WELL DRILLERS LOG

HARRISON
G
2033

2-13 1986 St. Braden Pump Wells Harrison
 date well completed firm name county well located

LANDOWNER: Paul Reno
Rt. 5 - Box 776 - George Street
Cultport, Miss. 39505
 (mailing address)

WELL LOCATION:
 sec 36 T 6 S R 11 W
4 miles E of Lymona
 (distance) (direction) (nearest town)

WELL PURPOSE: None
 (home, irrigation, municipal, industrial)

- WELL COMPLETION DATA:**
- (1) diameter (inches) 2"
 - (2) total depth (feet) 90
 - (3) static water level (feet) 20 below top of ground.
 - (4) casing PVC Total
 (material) (depth)
2"
 (size) If telescope see back.
 - (5) screen 10 70
 (length) (depth to top)
2" PVC .0085/17
 (size) (material)
 - (6) pump 1 10
 (HP) (yield gpm)
220V 1Ø
 (type power)
 - (7) electric log No
 (yes or no)
- (organization running log)
- (8) how well bottom plugged 2" Sand
PVC 5' hard

description of formations encountered	from	to
Surface	0	6
Red Clay	6	24
White Clay	24	45
Red Sandy clay	45	65
White Sand	65	70
Blue Clay	70	90+


RECEIVED
 MAR 31 1986

Department of Natural Resources
 Bureau of Land & Water Resources

DRILLERS REMARKS:
10 FT Tail pipe.

If well telescopes please sketch and show depths.

GROUND LEVEL

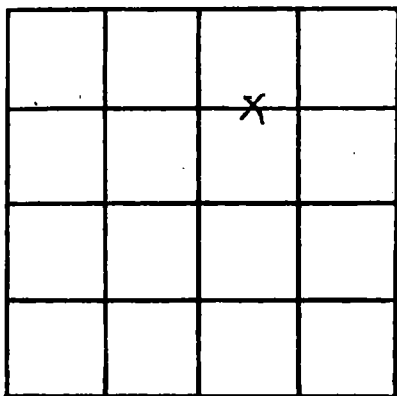

SECTION 36

Please indicate well location X.

ADDITIONAL INFORMATION

If more than one screen, show locations of each on sketch.