

MISSISSIPPI DEPARTMENT OF NATURAL RESOURCES
Bureau of Land and Water Resources
 Southport Mall
 P.O. Box 10631
 Jackson, Mississippi 39209
WATER WELL DRILLERS LOG

HARRISON
G
2035

date well completed 6/5/85 19 Syman Well Co. firm name Harrison county well located

LANDOWNER: Culpepper Mobile Homes
P.O. Box 596
Carthage, Ms 39051
 (mailing address)

description of formations encountered	from	to
	<u>white clay</u>	<u>0</u>
<u>gray clay</u>	<u>40</u>	<u>140</u>
<u>WHITE CLAY</u>	<u>140</u>	<u>250</u>
<u>BLUE CLAY</u>	<u>250</u>	<u>320</u>
<u>CAR SE SAND</u>	<u>320</u>	<u>340</u>

WELL LOCATION:
 sec. 29 T-6 N R-11 E
 S W
3 miles north of Shiloh
 (distance) (direction) (nearest town)

WELL PURPOSE: Home
 (home, irrigation, municipal, industrial)

- WELL COMPLETION DATA:
- diameter (inches) 2"
 - total depth (feet) 340'
 - static water level (feet) 65' below top of ground. above
 - casing PVC, 330'
 (material) (depth)
2"
 (size) if telescope see back.
 - screen 10', 330'
 (length) (depth to top)
2" PVC
 (size) (material)
 - pump 1 (HP) (yield gpm)
electric
 (type power)
 - electric log NO
 (yes or no)
NO
 (organization running log)
 - how well bottom plugged sand
shark


RECEIVED
 APR 9 1986

DRILLERS REMARKS:

Department of Natural Resources
 Bureau of Land & Water Resources

If well telescopes please sketch and show depths.

GROUND LEVEL

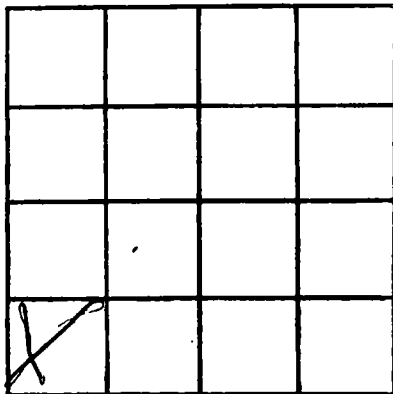

SECTION 29

Please indicate well location X.

ADDITIONAL INFORMATION

If more than one screen,
show locations of each on sketch.