

MISSISSIPPI DEPARTMENT OF NATURAL RESOURCES

Bureau of Land and Water Resources

Southport Mall

P.O. Box 10631

Jackson, Mississippi 39209

WATER WELL DRILLERS LOG

HARRISON
G
2036

10/14/85 date well completed
Lipman Well Co firm name
Harrison county well located

LANDOWNER: Phillip Conn
Rt. 3, Box 131
Gulfport 39503
(mailing address)

description of formations encountered	from	to
	white clay	0
blue clay	21	213
sand	214	233

WELL LOCATION:
sec. 24 T. 6 N. R. 11 E
0 miles of (distance) of (direction) of (nearest town)

WELL PURPOSE: home
(home, irrigation, municipal, industrial)

WELL COMPLETION DATA:

- (1) diameter (inches) 2"
- (2) total depth (feet) 230'
- (3) static water level (feet) 50' below top of ground
- (4) casing PVC 220' (material), (depth)
2" (size) if telescope see back.
- (5) screen 10' 220' (length), (depth to top)
2" (size), PVC (material)
- (6) pump 1 (HP) 10 (yield gpm)
electric (type power)
- (7) electric log No (yes or no)
No (organization running log)
- (8) how well bottom plugged sand shark


DRILLERS REMARKS:

RECEIVED
APR 9 1986

Department of Natural Resources
Bureau of Land & Water

If well telescopes please sketch and show depths.

GROUND LEVEL

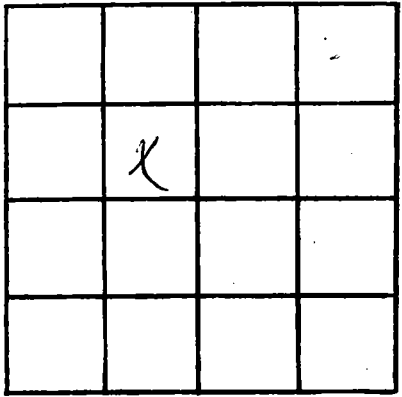

SECTION 24

Please indicate well location X.

ADDITIONAL INFORMATION

If more than one screen, show locations of each on sketch.